DIRECTION	MILEPOINT	LOCATION CODE (SHEET 4)	SIGN CODE	WIDTH (IN)	HEIGHT (IN)	SHEETING REMARKS	SIGN LEGEND	NEW SIGNS "A"	NEW SIGNS "B"	EXISTING SIGNS RETAIN	EXISTING SIGNS SALVAGE FROM	EXISTING SIGNS SALVAGE TO	EXISTING SIGNS REMOVE	EXIST POST RETAIN	EXIST POST REMOVE	NUMBER OF NEW POSTS	SQUARE STEEL (IN) 1.75 (LB / FT) 1.88	SQUARE STEEL (IN) 2.00 (LB / FT) 2.42	SQUARE STEEL (IN) 2.50 (LB / FT) 3.35	FOUNDATION	TUBULAR STEEL Ø (IN) 3.00 (LB / FT) 7.60	TUBULAR STEEL Ø (IN) 3.50 (LB / FT) 9.00	TUBULAR STEEL Ø (IN) 4.00 (LB / FT) 10.80	TUBULAR STEEL Ø (IN) 5.00 (LB / FT) 14.60	SIGN FRAME REQUIRED	REMARKS	SIGN DETAIL LOCATION SHSM	SIGN DETAIL LOCATION SIGN DETAILS SHEET #	SIGN DETAIL LOCATION STANDARD SHEET #
NB SHREWSBURY VT ROUTE 103							FY-FLUORESCENT YELLOW FYG-FLUORESCENT YELLOW GREEN																			"SHSM"-STANDARD HIGHWAY SIGNS AND MARKINGS BOOK			
NB	0.622	AB	D3-1				Shrewsbury Library -->			1				X														
NB	0.714	A	R2-1				SPEED LIMIT 35						1	X														
		A	R2-1	24	30		9/14/17	5.00																	INSTALL ON RETAINED POST	X		
NB	0.840	A	R2-1				9/15/17						1	X														
		A	R2-1	24	30			5.00																			INSTALL ON RETAINED POST	X		
NB	1.031	A	R2-1				9/14/17						1	X														
		A	R2-1	24	30			5.00																			INSTALL ON RETAINED POST	X		
NB	1.087	A	VW-060				HIDDEN DRIVES						1		X													
NB	1.134	A	VD-062B				OFFICIAL BUSINESS DIRECTIONAL SIGN			1				X													SPRING LAKE RANCH			
NB	1.440	A	W1-4	30	30		9/15/17	6.25								1		14'-0" X								INSTALL ±430' DOWNSTATION OF EXISTING SIGN AT MP 1.522 NB	X		
NB	1.522	A	VD-701				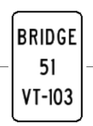 9/14/17						1		X															
		A	VD-701	6	10			0.42								1	7'-0" X												T-42
NB	2.055	A	VD-701				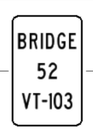 9/14/17						1		X															
		A	VD-701	6	10			0.42								1	7'-3" X												T-42
SIGN SUMMARY SHEET							SHEET TOTALS	22.08	0.00	2	0	0	6	0	0	3		35.0		0	0.0	0.0	0.0	0.0					
								SF	SF	EA	EA	EA	EA	EA	EA	EA		FT		EA	LB	LB	LB	LB					
VERMONT AGENCY OF TRANSPORTATION							TOWN DIRECTIONAL TOTALS	190.2	0.0	12	1	1	35	0	0	20		290.0		0	0.0								

PROJECT NAME: **STATEWIDE-SOUTH REGION**
PROJECT NUMBER: **STPG SIGN(57)**
FILE NAME: **z16t041Shrewsburv103NB.xls** PLOT DATE: **2/27/2017**
PROJECT MANAGER: **D. MUNRO** DRAWN BY: **W. GORDON**
DESIGNED BY: **P. MCKECHNIE** CHECKED **BRZEZOWSK**
SHREWSBURY VT-103 NB 3 SHEET **124** OF **264**