DIRECTION	MILEPOINT	LOCATION CODE (SHEET 4)	SIGN CODE	WIDTH (IN)	HEIGHT (IN)	SHEETING REMARKS	SIGN LEGEND	NEW SIGNS "A"	NEW SIGNS "B"	EXISTING SIGNS RETAIN	EXISTING SIGNS SALVAGE FROM	EXISTING SIGNS SALVAGE TO	EXISTING SIGNS REMOVE	EXIST POST RETAIN	EXIST POST REMOVE	NUMBER OF NEW POSTS	SQUARE STEEL (IN) 1.75 (LB / FT) 1.88	SQUARE STEEL (IN) 2.00 (LB / FT) 2.42	SQUARE STEEL (IN) 2.50 (LB / FT) 3.35	TUBULAR STEEL Ø (IN) FOUNDATION	TUBULAR STEEL Ø (IN) 3.00 (LB / FT) 7.60	TUBULAR STEEL Ø (IN) 3.50 (LB / FT) 9.00	TUBULAR STEEL Ø (IN) 4.00 (LB / FT) 10.80	TUBULAR STEEL Ø (IN) 5.00 (LB / FT) 14.60	SIGN FRAME REQUIRED	REMARKS	SIGN DETAIL LOCATION SHSM	SIGN DETAIL LOCATION SIGN DETAILS SHEET #	SIGN DETAIL LOCATION STANDARD SHEET #
SB SHREWSBURY VT ROUTE 103							FY-FLUORESCENT YELLOW FYG-FLUORESCENT YELLOW GREEN																			"SHSM"-STANDARD HIGHWAY SIGNS AND MARKINGS BOOK			
SB	3.820	F	R4-3				10/11/17						1																
		F	R4-3	24	30			5.00								1		12'-6" X									X		
SB	3.675	F	R4-3	24	30		10/11/17	5.00								1		14'-0" X								INSTALL SIGN ±765' DOWNSTATION FROM EXISTING SIGN AT MP 3.820 SB	X		
SB	3.506	F	W9-1										1		X														
SB	3.504	F	W9-1	36	36		10/12/17	9.00								2		14'-0" 12'-9" X								INSTALL SIGN 10' DOWNSTATION FROM EXISTING	X		
SB	3.455	F	W4-2R										1	X															
		F	W4-2R	36	36		11/28/17	9.00																		INSTALL ON RETAINED POSTS	X		
SB	3.373	F	VD-062B				OFFICIAL BUSINESS DIRECTIONAL SIGN			1				X												Crisanver House next left			
			VD-062B				OFFICIAL BUSINESS DIRECTIONAL SIGN			1																Pierce's Store next left			
SB	3.286	F	W2-3L										1	X															
		F	W16-8P				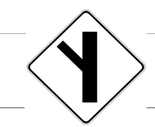 10/12/17						1																	
		F	W2-3L	30	30		11/28/17	6.25																	INSTALL ON RETAINED POST	X		
		F	W16-8P	33	8			1.83																				5	
SB	2.442	F	W10-1										1		X														
		F	W10-1	36	36		10/12/17	7.07								1		13'-3" X								36" DIAMETER	X		
SIGN SUMMARY SHEET							SHEET TOTALS	43.15	0.00	2	0	0	6	0	0	5		75.0		0	0.0	0.0	0.0	0.0				
								SF	SF	EA	EA	EA	EA	EA	EA	EA		FT		EA	LB	LB	LB	LB				
VERMONT AGENCY OF TRANSPORTATION							TOWN DIRECTIONAL TOTALS	220.6	0.0	7	1	1	37	0	1	26		380.0		0	0.0							

PROJECT NAME: **STATEWIDE-SOUTH REGION**
PROJECT NUMBER: **STPG SIGN(57)**
FILE NAME: **z16t041Shrewsburv103SB.xls** PLOT DATE: **2/27/2017**
PROJECT MANAGER: **D. MUNRO** DRAWN BY: **W. GORDON**
DESIGNED BY: **P. MCKECHNIE** CHECKED **BRZEZOWSK**
SHREWSBURY VT-103 SB 2 SHEET **129** OF **264**