DIRECTION	MILEPOINT	LOCATION CODE (SHEET 4)	SIGN CODE	WIDTH (IN)	HEIGHT (IN)	SHEETING REMARKS	SIGN LEGEND	NEW SIGNS "A"	NEW SIGNS "B"	EXISTING SIGNS RETAIN	EXISTING SIGNS SALVAGE FROM	EXISTING SIGNS SALVAGE TO	EXISTING SIGNS REMOVE	EXIST POST RETAIN	EXIST POST REMOVE	NUMBER OF NEW POSTS	SQUARE STEEL (IN) 1.75 (LB / FT) 1.88	SQUARE STEEL (IN) 2.00 (LB / FT) 2.42	SQUARE STEEL (IN) 2.50 (LB / FT) 3.35	TUBULAR STEEL Ø (IN) FOUNDATION	TUBULAR STEEL Ø (IN) 3.00 (LB / FT) 7.60	TUBULAR STEEL Ø (IN) 3.50 (LB / FT) 9.00	TUBULAR STEEL Ø (IN) 4.00 (LB / FT) 10.80	TUBULAR STEEL Ø (IN) 5.00 (LB / FT) 14.60	SIGN FRAME REQUIRED	REMARKS	SIGN DETAIL LOCATION SHSM	SIGN DETAIL LOCATION SIGN DETAILS SHEET #	SIGN DETAIL LOCATION STANDARD SHEET #
NB CLARENDON VT ROUTE 103							FY-FLUORESCENT YELLOW FYG-FLUORESCENT YELLOW GREEN																			"SHSM"-STANDARD HIGHWAY SIGNS AND MARKINGS BOOK			
		A	M4-6				END						1																
		A	VM1-5				VERMONT 103						1																
		A	M3-3	24	12		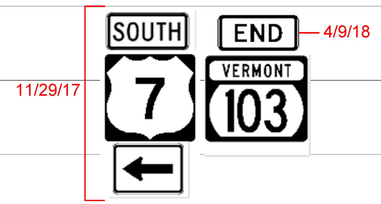	2.00																1B ~~2B~~	INSTALL ON RETAINED POST SOUTH, BLACK ON WHITE	X		
		A	M1-4	24	24			4.00																		TYPE 1B FRAME USED DUE TO LACK OF THIRD SIGN BELOW "103"	X		
		A	M6-1	21	15			2.19																		ARROW, BLACK ON WHITE	X		
		A	M4-6	24	12			2.00																		END, GREEN ON WHITE	X		
		A	VM1-5	30	24			5.00																					E-136
NB	1.952	K	R4-7				KEEP RIGHT			1				X															
		K	OM1-1				OBJECT MARKER			1																			
		J	OM1-1				OBJECT MARKER			1																			
		L	OM1-1				OBJECT MARKER			1																			
		K					DELINEATOR			1																			
		J					DELINEATOR			1																			
NB	1.966	A	R6-1R				ONE WAY RIGHT			1				X															
		B	R6-1L				ONE WAY LEFT			1																			
SIGN SUMMARY SHEET							SHEET TOTALS	15.19	0.00	8	0	0	2	0	0	0		0.0		0	0.0	0.0	0.0	0.0					
								SF	SF	EA	EA	EA	EA	EA	EA	EA		FT		EA	LB	LB	LB	LB					
VERMONT AGENCY OF TRANSPORTATION							TOWN DIRECTIONAL TOTALS	182.0	0.0	16	2	2	53	0	0	14		200.0		0		0.0							

PROJECT NAME: **STATEWIDE-SOUTH REGION**
PROJECT NUMBER: **STPG SIGN(57)**
FILE NAME: **z16t041Clarendon103 NB.xls** PLOT DATE: **2/27/2017**
PROJECT MANAGER: **D. MUNRO** DRAWN BY: **W. GORDON**
DESIGNED BY: **P. MCKECHNIE** CHECKED **BRZEZOWSK**
CLARENDON VT-103 NB 8 SHEET **141** OF **264**