DIRECTION	MILEPOINT	LOCATION CODE (SHEET 4)	SIGN CODE	WIDTH (IN)	HEIGHT (IN)	SHEETING REMARKS	SIGN LEGEND	NEW SIGNS "A"	NEW SIGNS "B"	EXISTING SIGNS RETAIN	EXISTING SIGNS SALVAGE FROM	EXISTING SIGNS SALVAGE TO	EXISTING SIGNS REMOVE	EXIST POST RETAIN	EXIST POST REMOVE	NUMBER OF NEW POSTS	SQUARE STEEL (IN) 1.75 (LB / FT) 1.88	SQUARE STEEL (IN) 2.00 (LB / FT) 2.42	SQUARE STEEL (IN) 2.50 (LB / FT) 3.35	FOUNDATION	TUBULAR STEEL Ø (IN) 3.00 (LB / FT) 7.60	TUBULAR STEEL Ø (IN) 3.50 (LB / FT) 9.00	TUBULAR STEEL Ø (IN) 4.00 (LB / FT) 10.80	TUBULAR STEEL Ø (IN) 5.00 (LB / FT) 14.60	SIGN FRAME REQUIRED	REMARKS	SIGN DETAIL LOCATION SHSM	SIGN DETAIL LOCATION SIGN DETAILS SHEET #	SIGN DETAIL LOCATION STANDARD SHEET #
SB CLARENDON VT ROUTE 103							FY-FLUORESCENT YELLOW FYG-FLUORESCENT YELLOW GREEN																			"SHSM"-STANDARD HIGHWAY SIGNS AND MARKINGS BOOK			
		F	VM1-5				VERMONT 7B						1																
		F	M6-1				LEFT ARROW						1																
		F	M3-3				SOUTH						1																
		F	VM1-5				VERMONT 103						1																
		F	M6-3				UP ARROW						1																
		F	M3-3				SOUTH						1																
		F	VM1-5				VERMONT 7B						1																
		F	M6-1L				RIGHT ARROW						1																
		F	M3-1	24	12			2.00								2			17'-3" 16'-6" X						3C	SLIP BASES REQUIRED SEE SHEET 4 NORTH, GREEN ON WHITE	X		
		F	VM1-5	24	24			4.00																					E-136
		F	M6-1L	21	15		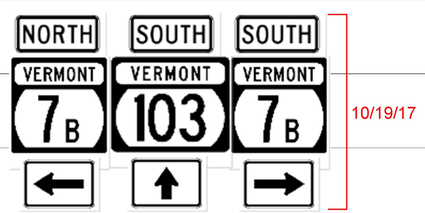	2.19																			ARROW, GREEN ON WHITE	X		
		F	M3-3	24	12			2.00																			SOUTH, GREEN ON WHITE	X		
		F	VM1-5	30	24			5.00																					E-136
		F	M6-3	21	15			2.19																			ARROW, GREEN ON WHITE	X		
		F	M3-3	24	12			2.00																			SOUTH, GREEN ON WHITE	X		
SIGN SUMMARY SHEET							SHEET TOTALS	19.38	0.00	0	0	0	8	0	0	2		30.0		0	0.0	0.0	0.0	0.0					
								SF	SF	EA	EA	EA	EA	EA	EA	EA		FT		EA	LB	LB	LB	LB					
VERMONT AGENCY OF TRANSPORTATION							TOWN DIRECTIONAL TOTALS	142.7	0.0	4	1	1	34	0	0	13		185.0		0	0.0								

PROJECT NAME: **STATEWIDE-SOUTH REGION**
PROJECT NUMBER: **STPG SIGN(57)**
FILE NAME: **z16t041Clarendon103 SB.xls**
PROJECT MANAGER: **D. MUNRO**
DESIGNED BY: **P. MCKECHNIE**
CLARENDON VT-103 SB 2
PLOT DATE: **2/27/2017**
DRAWN BY: **W. GORDON**
CHECKED BY: **BRZEZOWSK**
SHEET **144** OF **264**