DIRECTION	MILEPOINT	LOCATION CODE (SHEET 4)	SIGN CODE	WIDTH (IN)	HEIGHT (IN)	SHEETING REMARKS	SIGN LEGEND	NEW SIGNS "A"	NEW SIGNS "B"	EXISTING SIGNS RETAIN	EXISTING SIGNS SALVAGE FROM	EXISTING SIGNS SALVAGE TO	EXISTING SIGNS REMOVE	EXIST POST RETAIN	EXIST POST REMOVE	NUMBER OF NEW POSTS	SQUARE STEEL (IN) 1.75 (LB / FT) 1.88	SQUARE STEEL (IN) 2.00 (LB / FT) 2.42	SQUARE STEEL (IN) 2.50 (LB / FT) 3.35	TUBULAR STEEL Ø (IN) FOUNDATION	TUBULAR STEEL Ø (IN) 3.00 (LB / FT) 7.60	TUBULAR STEEL Ø (IN) 3.50 (LB / FT) 9.00	TUBULAR STEEL Ø (IN) 4.00 (LB / FT) 10.80	TUBULAR STEEL Ø (IN) 5.00 (LB / FT) 14.60	SIGN FRAME REQUIRED	REMARKS	SIGN DETAIL LOCATION SHSM	SIGN DETAIL LOCATION SIGN DETAILS SHEET #	SIGN DETAIL LOCATION STANDARD SHEET #
NB VERNON VT ROUTE 142							FY-FLUORESCENT YELLOW FYG-FLUORESCENT YELLOW GREEN																				"SHSM"-STANDARD HIGHWAY SIGNS AND MARKINGS BOOK			
		A	VD-700				MILE MARKER 1420 / 1318 / 0760				1		1																
NB	7.610	A	W11-1	30	30		11/15/17	6.25								1		17'-3" X								INSTALL SIGN ±350' UPSTATION FROM EXISTING SIGN AT MP 7.544 NB	X		
		A	W16-1P	18	24		SHARE THE ROAD	3.00																			X		
		A	VD-700				MILE MARKER 1420 / 1318 / 0760					1																		
NB	7.850	A	W11-2				PEDESTRIAN TRAFFIC						1		X														
		A	VW-207BP				BLIND PERSON (PLAQUE)						1																
		A	W7-3aP				NEXT 1/2 MILE						1																
		A	W11-2	30	30	FYG	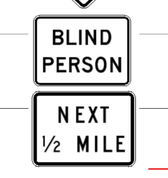 11/15/17	6.25								1		16'-9" X								INSTALL NEW POST IN SAME LOCATION BEHIND GUARDRAIL	X		
		A	VW-207BP	24	18	FYG	BLIND PERSON	3.00																				5	
		A	W7-3aP	24	18	FYG	NEXT ½ MILE	3.00																			X		
NB	7.890	A	W3-5				11/15/17						1	X															
		A	W3-5	36	36		SPEED LIMIT 40	9.00																			INSTALL ON RETAINED POSTS	X		
NB	8.005	A	R2-1				SPEED LIMIT 40						1		X														
		A	VD-700				MILE MARKER 1420 / 1318 / 0800				1		1																
		A	R2-1	~~24~~ 30	~~30~~ 36		SPEED LIMIT 40 4/9/18L	~~5.00~~ 7.50								1		13'-0" X									X		
SIGN SUMMARY SHEET							SHEET TOTALS	35.50	0.00	0	2	1	7	0	0	3		45.0		0	0.0	0.0	0.0	0.0					
								SF	SF	EA	EA	EA	EA	EA	EA	EA		FT		EA	LB	LB	LB	LB					
VERMONT AGENCY OF TRANSPORTATION							TOWN DIRECTIONAL TOTALS	615.1	0.0	21	16	16	132	0	0	110		1630.0		0	0.0								

PROJECT NAME: **STATEWIDE-SOUTH REGION**
PROJECT NUMBER: **STPG SIGN(57)**
FILE NAME: **z16t041Vernon142 NB.xls** PLOT DATE: **2/27/2017**
PROJECT MANAGER: **D. MUNRO** DRAWN BY: **W. GORDON**
DESIGNED BY: **P. MCKECHNIE** CHECKED **BRZEZOWSK**
VERNON VT-142 NB 17 SHEET **165** OF **264**