DIRECTION	MILEPOINT	LOCATION CODE (SHEET 4)	SIGN CODE	WIDTH (IN)	HEIGHT (IN)	SHEETING REMARKS	SIGN LEGEND	NEW SIGNS "A"	NEW SIGNS "B"	EXISTING SIGNS RETAIN	EXISTING SIGNS SALVAGE FROM	EXISTING SIGNS SALVAGE TO	EXISTING SIGNS REMOVE	EXIST POST RETAIN	EXIST POST REMOVE	NUMBER OF NEW POSTS	SQUARE STEEL (IN) 1.75 (LB / FT) 1.88	SQUARE STEEL (IN) 2.00 (LB / FT) 2.42	SQUARE STEEL (IN) 2.50 (LB / FT) 3.35	TUBULAR STEEL Ø (IN) FOUNDATION	TUBULAR STEEL Ø (IN) 3.00 (LB / FT) 7.60	TUBULAR STEEL Ø (IN) 3.50 (LB / FT) 9.00	TUBULAR STEEL Ø (IN) 4.00 (LB / FT) 10.80	TUBULAR STEEL Ø (IN) 5.00 (LB / FT) 14.60	SIGN FRAME REQUIRED	REMARKS	SIGN DETAIL LOCATION SHSM	SIGN DETAIL LOCATION SIGN DETAILS SHEET #	SIGN DETAIL LOCATION STANDARD SHEET #
SB VERNON VT ROUTE 142							FY-FLUORESCENT YELLOW FYG-FLUORESCENT YELLOW GREEN																			"SHSM"-STANDARD HIGHWAY SIGNS AND MARKINGS BOOK			
		F	W1-10c	36	36	FY	4/9/18	9.00								2		13'-3" 12'-9" X									X		
		F	W16-8P	30	8	FY	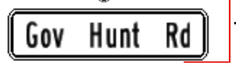	1.67																				4	
SB	4.230	F	W1-4L				11/20/17						1		X														
		F	W1-4L	30	30			6.25								1		14'-0" X									X		
SB	4.155	F	R2-1				11/20/17						1		X														
		F	R2-1	24	30			5.00								1		13'-3" X									X		
SB	4.028	F					VERNON'S FIRST MEETING HOUSE HISTORIC SIGN			1				X															
SB	3.985	F					COMBINATION LEFT TURN/ SIDE ROAD						1		X														
		F	W13-1P				30 M.P.H.						1																
		F		36	36	FY	11/20/17	9.00								2		16'-3" 15'-9" X										2	
		F	W13-1P	24	24	FY		4.00																		INSTALL ON LEFT POST	X		
SB	3.910	FE	D3-1				11/21/17 Pond Rd				1	1	1		X	1		10'-0" X								POND RD (TH-2) SALVAGE SIGN TO NEW POST AT SAME STATION			
SB	3.908	G	VR-017				11/20/17						1	X															
		G	VR-017	24	30			5.00																		INSTALL ON RETAINED POST			T-70
SB	3.895	H	R1-1				STOP						1		X														
							SHEET TOTALS	39.92 SF	0.00 SF	1 EA	1 EA	1 EA	7 EA	0 EA	0 EA	7 EA		105.0 FT			0 EA	0.0 LB	0.0 LB	0.0 LB	0.0 LB					
							TOWN DIRECTIONAL TOTALS	485.1	0.0	14	12	12	104	0	0	88		1310.0			0	0.0									

SIGN SUMMARY SHEET

VERMONT AGENCY OF TRANSPORTATION

PROJECT NAME: **STATEWIDE-SOUTH REGION**
PROJECT NUMBER: **STPG SIGN(57)**
FILE NAME: **z16t041Vernon142 SB.xls**
PROJECT MANAGER: **D. MUNRO**
DESIGNED BY: **P. MCKECHNIE**
VERNON VT-142 SB 7
PLOT DATE: **2/27/2017**
DRAWN BY: **W. GORDON**
CHECKED **BRZEZOWSK**
SHEET **175** OF **264**