DIRECTION	MILEPOINT	LOCATION CODE (SHEET 4)	SIGN CODE	WIDTH (IN)	HEIGHT (IN)	SHEETING REMARKS	SIGN LEGEND	NEW SIGNS "A"	NEW SIGNS "B"	EXISTING SIGNS RETAIN	EXISTING SIGNS SALVAGE FROM	EXISTING SIGNS SALVAGE TO	EXISTING SIGNS REMOVE	EXIST POST RETAIN	EXIST POST REMOVE	NUMBER OF NEW POSTS	SQUARE STEEL (IN) 1.75 (LB / FT) 1.88	SQUARE STEEL (IN) 2.00 (LB / FT) 2.42	SQUARE STEEL (IN) 2.50 (LB / FT) 3.35	FOUNDATION	TUBULAR STEEL Ø (IN) 3.00 (LB / FT) 7.60	TUBULAR STEEL Ø (IN) 3.50 (LB / FT) 9.00	TUBULAR STEEL Ø (IN) 4.00 (LB / FT) 10.80	TUBULAR STEEL Ø (IN) 5.00 (LB / FT) 14.60	SIGN FRAME REQUIRED	REMARKS	SIGN DETAIL LOCATION SHSM	SIGN DETAIL LOCATION SIGN DETAILS SHEET #	SIGN DETAIL LOCATION STANDARD SHEET #
NB BRATTLEBORO VT ROUTE 142							FY-FLUORESCENT YELLOW FYG-FLUORESCENT YELLOW GREEN																			"SHSM"-STANDARD HIGHWAY SIGNS AND MARKINGS BOOK			
		A	R2-1	24	30		11/9/17	5.00								1		13'-9" X									X		
NB	0.897	A	W1-2L				LEFT CURVE						1		X														
		A	W1-10L	36	36		11/9/17	9.00								2		15'-0" 14'-3" X									X		
		A	W16-8P	30	8			1.67																				4	
NB	0.970	A					REDUCE SPEED AHEAD						1		X											TOWN INSTALLED NEW SPEED LIMIT SIGNS LATE 2017			
NB	0.974	A	W3-5	36	36		LATE 2017	9.00								2		14'-3" 13'-6" X									X		
NB	0.991	AB					BRATTLEBORO WASTEWATER TREATMENT 340 RIVERSIDE DRIVE			1				X															
NB	1.007	AB	D3-1				11/9/17 Riverside Dr				1	1	1		X	1		13'-3" X											
		D	R1-1				STOP				1	1	1																
NB	1.012	A	VD-018A				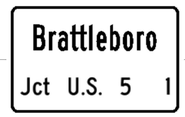 11/9/17						1	X															
		A	VD-018A	36	24			6.00																			INSTALL ON RETAINED POST		T-95
NB	1.058	A	W10-12				SKEWED CROSSING						1		X														
NB	1.085	A	W10-1				RAILROAD CROSSING						1		X														
SIGN SUMMARY SHEET							SHEET TOTALS	30.67	0.00	1	2	2	7	0	0	6		90.0		0	0.0	0.0	0.0	0.0					
								SF	SF	EA	EA	EA	EA	EA	EA	EA		FT		EA	LB	LB	LB	LB					
VERMONT AGENCY OF TRANSPORTATION							TOWN DIRECTIONAL TOTALS	209.8	0.0	7	4	4	50	0	0	30		420.0		2	236.0								

PROJECT NAME: **STATEWIDE-SOUTH REGION**
PROJECT NUMBER: **STPG SIGN(57)**
FILE NAME: **z16t041Brattleboro142 NB.xls** PLOT DATE: **2/27/2017**
PROJECT MANAGER: **D. MUNRO** DRAWN BY: **W. GORDON**
DESIGNED BY: **P. MCKECHNIE** CHECKED **BRZEZOWSK**
BRATTLEBORO VT-142 NB 3 SHEET **186** OF **264**