DIRECTION	MILEPOINT	LOCATION CODE (SHEET 4)	SIGN CODE	WIDTH (IN)	HEIGHT (IN)	SHEETING REMARKS	SIGN LEGEND	NEW SIGNS "A"	NEW SIGNS "B"	EXISTING SIGNS RETAIN	EXISTING SIGNS SALVAGE FROM	EXISTING SIGNS SALVAGE TO	EXISTING SIGNS REMOVE	EXIST POST RETAIN	EXIST POST REMOVE	NUMBER OF NEW POSTS	SQUARE STEEL (IN) 1.75 (LB / FT) 1.88	SQUARE STEEL (IN) 2.00 (LB / FT) 2.42	SQUARE STEEL (IN) 2.50 (LB / FT) 3.35	FOUNDATION	TUBULAR STEEL Ø (IN) 3.00 (LB / FT) 7.60	TUBULAR STEEL Ø (IN) 3.50 (LB / FT) 9.00	TUBULAR STEEL Ø (IN) 4.00 (LB / FT) 10.80	TUBULAR STEEL Ø (IN) 5.00 (LB / FT) 14.60	SIGN FRAME REQUIRED	REMARKS	SIGN DETAIL LOCATION SHSM	SIGN DETAIL LOCATION SIGN DETAILS SHEET #	SIGN DETAIL LOCATION STANDARD SHEET #
SB BRATTLEBORO VT ROUTE 142							FY-FLUORESCENT YELLOW FYG-FLUORESCENT YELLOW GREEN																			"SHSM"-STANDARD HIGHWAY SIGNS AND MARKINGS BOOK			
SB	0.320	F	VW-205										1		X														
		F	W7-3aP				11/13/17						1															
		F	VW-205	30	30			6.25								1		12'-6" X											T-81
		F	W7-3aP	24	18			3.00																			X		
SB	0.135	F	R2-1	24	30		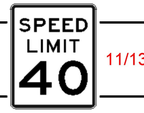 11/13/17	5.00								1		13'-3" X								INSTALL SIGN 80' UPSTATION FROM EXISTING SIGN AT MP 0.120 SB	X		
SB	0.120	F	R2-1				SPEED LIMIT 40						1		X														
SB	0.095	F					NO PARKING ANYTIME						1		X														
SIGN SUMMARY SHEET							SHEET TOTALS	14.25	0.00	0	0	0	4	0	0	2		30.0		0	0.0	0.0	0.0	0.0					
								SF	SF	EA	EA	EA	EA	EA	EA	EA		FT		EA	LB	LB	LB	LB					
VERMONT AGENCY OF TRANSPORTATION							TOWN DIRECTIONAL TOTALS	140.3	0.0	1	1	1	25	0	0	23		345.0		0		0.0							

PROJECT NAME: STATEWIDE-SOUTH REGION
PROJECT NUMBER: STPG SIGN(57)
FILE NAME: z16t041Brattleboro142 SB.xls
PROJECT MANAGER: D. MUNRO
DESIGNED BY: P. MCKECHNIE
BRATTLEBORO VT-142 SB 5
PLOT DATE: 2/27/2017
DRAWN BY: W. GORDON
CHECKED BRZEZOWSK
SHEET 196 OF 264