DIRECTION	MILEPOINT	LOCATION CODE (SHEET 4)	SIGN CODE	WIDTH (IN)	HEIGHT (IN)	SHEETING REMARKS	SIGN LEGEND	NEW SIGNS "A"	NEW SIGNS "B"	EXISTING SIGNS RETAIN	EXISTING SIGNS SALVAGE FROM	EXISTING SIGNS SALVAGE TO	EXISTING SIGNS REMOVE	EXIST POST RETAIN	EXIST POST REMOVE	NUMBER OF NEW POSTS	SQUARE STEEL (IN) 1.75 (LB / FT) 1.88	SQUARE STEEL (IN) 2.00 (LB / FT) 2.42	SQUARE STEEL (IN) 2.50 (LB / FT) 3.35	TUBULAR STEEL Ø (IN) FOUNDATION	TUBULAR STEEL Ø (IN) 3.00 (LB / FT) 7.60	TUBULAR STEEL Ø (IN) 3.50 (LB / FT) 9.00	TUBULAR STEEL Ø (IN) 4.00 (LB / FT) 10.80	TUBULAR STEEL Ø (IN) 5.00 (LB / FT) 14.60	SIGN FRAME REQUIRED	REMARKS	SIGN DETAIL LOCATION SHSM	SIGN DETAIL LOCATION SIGN DETAILS SHEET #	SIGN DETAIL LOCATION STANDARD SHEET #
EB WALLINGFORD VT RTE 140							FY-FLUORESCENT YELLOW FYG-FLUORESCENT YELLOW GREEN																			"SHSM"-STANDARD HIGHWAY SIGNS AND MARKINGS BOOK			
		C	M3-3				SOUTH			1																		
		C	VM5-1				VERMONT 155			1																		
		C	M6-1L				LEFT ARROW			1																		
		C	M3-4				WEST			1																		
		C	VM5-1				VERMONT 140			1																		
		C	M6-1R				RIGHT ARROW			1																		
EB	6.180	C	VR-017				11/2/17						1	X														
		C	VR-017	24	30			5.00																			INSTALL ON RETAINED POST			T-70
EB	6.186	D	R1-1				11/2/17						1		X													
		D	R1-1	30	30			6.25									1	13'-3" X										X	
EB	6.187	AB	D3-1	56	12		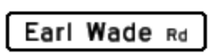 11/2/17	4.67									2	11'-0" 10'-3" X								INSTALL SIGN ±10' UPSTATION FROM STOP SIGN AT MP 6.186 EB		9	
EB	6.200	A	VD1-1A				(UP) Mount Holly 2			1				X															
		A	VD1-1A				(UP) Ludlow 11			1																			
		A	VD1-1A				Weston 14 -->			1																			
		A	VD1-1A				Londonderry 19 -->			1																			
SIGN SUMMARY SHEET							SHEET TOTALS	15.92	0.00	10	0	0	2	0	0	3		45.0		0	0.0	0.0	0.0	0.0					
								SF	SF	EA	EA	EA	EA	EA	EA	EA		FT		EA	LB	LB	LB	LB					
VERMONT AGENCY OF TRANSPORTATION							TOWN DIRECTIONAL TOTALS	489.4	0.0	46	4	4	100	0	0	86		1250.0		0			0.0						

PROJECT NAME: **STATEWIDE-SOUTH REGION**
PROJECT NUMBER: **STPG SIGN(57)**
FILE NAME: **z16t041Wallingford140EB.xls** PLOT DATE: **2/27/2017**
PROJECT MANAGER: **D. MUNRO** DRAWN BY: **W. GORDON**
DESIGNED BY: **P. MCKECHNIE** CHECKED **BRZEZOWSK**
WALLINGFORD VT-140 EB 16 SHEET **212** OF **264**