DIRECTION	MILEPOINT	LOCATION CODE (SHEET 4)	SIGN CODE	WIDTH (IN)	HEIGHT (IN)	SHEETING REMARKS	SIGN LEGEND	NEW SIGNS "A"	NEW SIGNS "B"	EXISTING SIGNS RETAIN	EXISTING SIGNS SALVAGE FROM	EXISTING SIGNS SALVAGE TO	EXISTING SIGNS REMOVE	EXIST POST RETAIN	EXIST POST REMOVE	NUMBER OF NEW POSTS	SQUARE STEEL (IN) 1.75 (LB / FT) 1.88	SQUARE STEEL (IN) 2.00 (LB / FT) 2.42	SQUARE STEEL (IN) 2.50 (LB / FT) 3.35	TUBULAR STEEL Ø (IN) FOUNDATION	TUBULAR STEEL Ø (IN) 3.00 (LB / FT) 7.60	TUBULAR STEEL Ø (IN) 3.50 (LB / FT) 9.00	TUBULAR STEEL Ø (IN) 4.00 (LB / FT) 10.80	TUBULAR STEEL Ø (IN) 5.00 (LB / FT) 14.60	SIGN FRAME REQUIRED	REMARKS	SIGN DETAIL LOCATION SHSM	SIGN DETAIL LOCATION SIGN DETAILS SHEET #	SIGN DETAIL LOCATION STANDARD SHEET #
WB WALLINGFORD VT RTE 140							FY-FLUORESCENT YELLOW FYG-FLUORESCENT YELLOW GREEN																			"SHSM"-STANDARD HIGHWAY SIGNS AND MARKINGS BOOK			
		F	W13-1P	18 ~~24~~	18 ~~24~~			2.25 ~~4.00~~																		INSTALL ON LEFT POST	X		
WB	6.086	FE	D3-1	64	12		Henry Knoll Ln 11/21/17	5.33								2		11'-0" X								INSTALL 35' UPSTATION FROM EXISTING HENRY KNOLL LN STREET SIGN		9	
WB	6.086	FE					HENRY KNOLL LN						1		X											HENRY KNOLL LN (TH-67)			
WB	6.070	F	R15-1				RAILROAD CROSS BUCK			1				X												ON RAILROAD SIGNAL POLE			
WB	6.059	F	W11-8				10/31/17						1		X															
		F	W11-8	30	30			6.25								1		X										X		
WB	5.990	F	W1-5L				WINDING ROAD						1		X															
		F	W7-3aP				NEXT 6 MILES						1																	
		F	W1-5L	30	30		11/21/17	6.25								2		15'-6" 15'-0" X										X		
		F	W13-1P	18	18			2.25																		INSTALL ON LEFT POST	X		
		F	W7-3aP	24	18		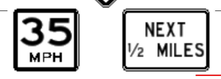	3.00																		INSTALL ON RIGHT POST	X		
WB	5.890	F	R2-1				10/31/17						1		X															
		F	R2-1	24	30			5.00								1		14'-0" X										X		
WB	5.679	F	W2-3R				SIDE ROAD						1	X																
SIGN SUMMARY SHEET							SHEET TOTALS	32.08	0.00	1	0	0	6	0	0	6		90.0		0	0.0	0.0	0.0	0.0					
								SF	SF	EA	EA	EA	EA	EA	EA	EA		FT		EA	LB	LB	LB	LB					
VERMONT AGENCY OF TRANSPORTATION							TOWN DIRECTIONAL TOTALS	572.0	0.0	35	2	2	128	0	0	93		1325.0		2		183.0							

PROJECT NAME: **STATEWIDE-SOUTH REGION**
PROJECT NUMBER: **STPG SIGN(57)**
FILE NAME: **z16t041Wallingford140WB.xls** PLOT DATE: **2/27/2017**
PROJECT MANAGER: **D. MUNRO** DRAWN BY: **W. GORDON**
DESIGNED BY: **P. MCKECHNIE** CHECKED **BRZEZOWSK**
WALLINGFORD VT-140 WB 4 SHEET **218** OF **264**