DIRECTION	MILEPOINT	LOCATION CODE (SHEET 4)	SIGN CODE	WIDTH (IN)	HEIGHT (IN)	SHEETING REMARKS	SIGN LEGEND	NEW SIGNS "A"	NEW SIGNS "B"	EXISTING SIGNS RETAIN	EXISTING SIGNS SALVAGE FROM	EXISTING SIGNS SALVAGE TO	EXISTING SIGNS REMOVE	EXIST POST RETAIN	EXIST POST REMOVE	NUMBER OF NEW POSTS	SQUARE STEEL (IN) 1.75 2.00 2.50 (LB / FT) 1.88 2.42 3.35	TUBULAR STEEL Ø (IN) 3.00 3.50 4.00 5.00 (LB / FT) 7.60 9.00 10.80 14.60	FOUNDATION	SIGN FRAME REQUIRED	REMARKS	SIGN DETAIL LOCATION SHSM	SIGN DETAILS SHEET #	STANDARD SHEET #
WB WALLINGFORD VT RTE 140							FY-FLUORESCENT YELLOW FYG-FLUORESCENT YELLOW GREEN														"SHSM"-STANDARD HIGHWAY SIGNS AND MARKINGS BOOK			
WB	4.788	FE	D3-1										1		X									
		FE	D3-1	64	12		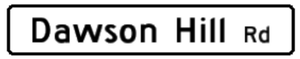 11/2/17	5.33								1	10'-6" 10'-3" X						9	
WB	4.420	F	W3-5				REDUCE SPEED AHEAD						1		X									
		F	W3-5	36	36		11/21/17	9.00								2	14'-6" 13'-9" X					X		
WB	4.380	F	W2-2R				SIDE ROAD						1		X									
WB	4.320	G	VR-017				11/2/17						1		X									
		G	VR-017	24	30			5.00								1	12'-6" X						T-70	
WB	4.314	FE	D3-1										1		X									
		H	R1-1										1											
		FE	D3-1	42	12		11/2/17	3.50								1	13'-3" X				INSTALL ON TOP OF STOP SIGN		9	
		H	R1-1	30	30			6.25														X		
WB	4.300	F	R2-1				11/4/17						1		X									
		F	R2-1	30	36			7.50								1	14'-3" X					X		
WB	3.870	F	W1-2R				RIGHT CURVE						1		X									
		F	W13-1P				30 MPH						1											
							SHEET TOTALS	36.58	0.00	0	0	0	9	0	0	6	90.0	0	0.0	0.0	0.0	0.0			
								SF	SF	EA	EA	EA	EA	EA	EA	EA	FT	EA	LB	LB	LB	LB			
							TOWN DIRECTIONAL TOTALS	572.0	0.0	35	2	2	128	0	0	93	1325.0	2	183.0						

SIGN SUMMARY SHEET

VERMONT AGENCY OF TRANSPORTATION

PROJECT NAME: **STATEWIDE-SOUTH REGION**
PROJECT NUMBER: **STPG SIGN(57)**
FILE NAME: **z16t041Wallingford140WB.xls** PLOT DATE: **2/27/2017**
PROJECT MANAGER: **D. MUNRO** DRAWN BY: **W. GORDON**
DESIGNED BY: **P. MCKECHNIE** CHECKED **BRZEZOWSK**
WALLINGFORD VT-140 WB 7 SHEET **221** OF **264**