DIRECTION	MILEPOINT	LOCATION CODE (SHEET 4)	SIGN CODE	WIDTH (IN)	HEIGHT (IN)	SHEETING REMARKS	SIGN LEGEND	NEW SIGNS "A"	NEW SIGNS "B"	EXISTING SIGNS RETAIN	EXISTING SIGNS SALVAGE FROM	EXISTING SIGNS SALVAGE TO	EXISTING SIGNS REMOVE	EXIST POST RETAIN	EXIST POST REMOVE	NUMBER OF NEW POSTS	SQUARE STEEL (IN) 1.75 (LB / FT) 1.88	SQUARE STEEL (IN) 2.00 (LB / FT) 2.42	SQUARE STEEL (IN) 2.50 (LB / FT) 3.35	FOUNDATION	TUBULAR STEEL Ø (IN) 3.00 (LB / FT) 7.60	TUBULAR STEEL Ø (IN) 3.50 (LB / FT) 9.00	TUBULAR STEEL Ø (IN) 4.00 (LB / FT) 10.80	TUBULAR STEEL Ø (IN) 5.00 (LB / FT) 14.60	SIGN FRAME REQUIRED	REMARKS	SIGN DETAIL LOCATION SHSM	SIGN DETAIL LOCATION SIGN DETAILS SHEET #	SIGN DETAIL LOCATION STANDARD SHEET #
WB WALLINGFORD VT RTE 140							FY-FLUORESCENT YELLOW FYG-FLUORESCENT YELLOW GREEN																				"SHSM"-STANDARD HIGHWAY SIGNS AND MARKINGS BOOK			
WB	0.205	F	W11-2										1		X														
		F	W16-7p				11/8/17						1																	
		F	W11-2	30	30	FYG		6.25								1		13'-9" X								PROVIDE 7' CLEAR HEIGHT	X		
		F	W16-7p	24	12	FYG		2.00																			X		
WB	0.165	F	M2-1										1	X															
		F	M1-4										1																
		F	M2-1	21	15		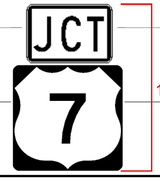 11/8/17	2.19																		INSTALL ON RETAINED POST	X		
		F	M1-4	24	24			4.00																			X		
WB	0.144	G	VR-017				LLL 24,000 LBS						1	X													PROSPECT ST (TH-10)			
		G					NO THRU TRUCKS						1																	
		G	R2-1				SPEED LIMIT 25						1																	
		G	VR-017	24	30		11/9/17	5.00																		INSTALL ON RETAINED POST			T-70
		G	R2-1	18	24		11/8/17	3.00																		STICKER ON BACK OF SIGN SHALL READ "WALLINGFORD", NOT "VAOT"	X		
WB	0.138	H	R1-1				STOP						1	X															
		G	VD-700				MILE MARKER 1400/1125/0014						1																	
SIGN SUMMARY SHEET							SHEET TOTALS	22.44	0.00	0	0	0	9	0	0	1	15.0			0	0.0	0.0	0.0	0.0					
								SF	SF	EA	EA	EA	EA	EA	EA	EA	FT			EA	LB	LB	LB	LB					
VERMONT AGENCY OF TRANSPORTATION							TOWN DIRECTIONAL TOTALS	572.0	0.0	35	2	2	128	0	0	93	1325.0			2	183.0								

PROJECT NAME: **STATEWIDE-SOUTH REGION**
PROJECT NUMBER: **STPG SIGN(57)**

FILE NAME: **z16t041Wallingford140WB.xls** PLOT DATE: **2/27/2017**
PROJECT MANAGER: **D. MUNRO** DRAWN BY: **W. GORDON**
DESIGNED BY: **P. MCKECHNIE** CHECKED **BRZEZOWSK**
WALLINGFORD VT-140 WB 16 SHEET **230** OF **264**