DIRECTION	MILEPOINT	LOCATION CODE (SHEET 4)	SIGN CODE	WIDTH (IN)	HEIGHT (IN)	SHEETING REMARKS	SIGN LEGEND	NEW SIGNS "A"	NEW SIGNS "B"	EXISTING SIGNS RETAIN	EXISTING SIGNS SALVAGE FROM	EXISTING SIGNS SALVAGE TO	EXISTING SIGNS REMOVE	EXIST POST RETAIN	EXIST POST REMOVE	NUMBER OF NEW POSTS	SQUARE STEEL (IN) 1.75 (LB / FT) 1.88	SQUARE STEEL (IN) 2.00 (LB / FT) 2.42	SQUARE STEEL (IN) 2.50 (LB / FT) 3.35	TUBULAR STEEL Ø (IN) FOUNDATION	TUBULAR STEEL Ø (IN) 3.00 (LB / FT) 7.60	TUBULAR STEEL Ø (IN) 3.50 (LB / FT) 9.00	TUBULAR STEEL Ø (IN) 4.00 (LB / FT) 10.80	TUBULAR STEEL Ø (IN) 5.00 (LB / FT) 14.60	SIGN FRAME REQUIRED	REMARKS	SIGN DETAIL LOCATION SHSM	SIGN DETAIL LOCATION SIGN DETAILS SHEET #	SIGN DETAIL LOCATION STANDARD SHEET #
NB MT HOLLY VT 155							FY-FLUORESCENT YELLOW FYG-FLUORESCENT YELLOW GREEN																			"SHSM"-STANDARD HIGHWAY SIGNS AND MARKINGS BOOK			
NB	4.267	D	R1-1										1		X														
		C	VD-700				MILE MARKER 1550/1112/0426				1		1																
		D	R1-1	30	30		11/2/17	6.25								1		14'-0" X								X		
		C	VD-700				MILE MARKER 1550/1112/0426					1														INSTALL BACK TO BACK ON STOP SIGN POST			
NB	4.267	AB	D3-1				TARBELLVILLE RD. (TH1)						1		X														
		AB	D3-1	72	12		11/2/17	6.00								2		11'-9" 11'-0" X								INSTALL 10' FROM STOP SIGN BETWEEN ROAD AND STOP SIGN		10	
NB	4.274	A					NORTH						1		X														
		A	VM1-5				VERMONT 155						1																
NB	4.290	A	M3-1	24	12		11/7/17	2.00								1		14'-0" X								NORTH, GREEN ON WHITE	X		
		A	VM1-5	30	24			5.00																		INSTALL 85' UPSTATION FROM EXISTING SIGN AT MP 4.274 NB			E-136
NB	4.380	A	S3-1				11/7/17						1		X														
		A	S3-1	36	36	FYG		9.00								2		14'-3" 14'-0" X									X		
NB	4.507	A	VD-701				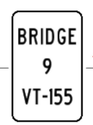 11/7/17						1		X														
		A	VD-701	6	10			0.42								1	8'-0" X												T-42
NB	4.535	A	R2-1				SPEED LIMIT 50						1		X														
							SHEET TOTALS	28.67	0.00	0	1	1	8	0	0	7		100.0		0	0.0	0.0	0.0	0.0					
								SF	SF	EA	EA	EA	EA	EA	EA	EA		FT		EA	LB	LB	LB	LB					
							TOWN DIRECTIONAL TOTALS	235.3	0.0	10	4	4	56	0	1	50		675.0		0	0.0								

SIGN SUMMARY SHEET

VERMONT AGENCY OF TRANSPORTATION

PROJECT NAME: **STATEWIDE-SOUTH REGION**
PROJECT NUMBER: **STPG SIGN(57)**
FILE NAME: **z16t041Mt HollvVT155 NB.xls** PLOT DATE: **2/27/2017**
PROJECT MANAGER: **D. MUNRO** DRAWN BY: **W. GORDON**
DESIGNED BY: **P. MCKECHNIE** CHECKED **BRZEZOWSK**
MOUNT HOLLY VT-155 NB 6 SHEET **247** OF **264**