DIRECTION	MILEPOINT	LOCATION CODE (SHEET 4)	SIGN CODE	WIDTH (IN)	HEIGHT (IN)	SHEETING REMARKS	SIGN LEGEND	NEW SIGNS "A"	NEW SIGNS "B"	EXISTING SIGNS RETAIN	EXISTING SIGNS SALVAGE FROM	EXISTING SIGNS SALVAGE TO	EXISTING SIGNS REMOVE	EXIST POST RETAIN	EXIST POST REMOVE	NUMBER OF NEW POSTS	SQUARE STEEL (IN) 1.75 (LB / FT) 1.88	SQUARE STEEL (IN) 2.00 (LB / FT) 2.42	SQUARE STEEL (IN) 2.50 (LB / FT) 3.35	FOUNDATION	TUBULAR STEEL Ø (IN) 3.00 (LB / FT) 7.60	TUBULAR STEEL Ø (IN) 3.50 (LB / FT) 9.00	TUBULAR STEEL Ø (IN) 4.00 (LB / FT) 10.80	TUBULAR STEEL Ø (IN) 5.00 (LB / FT) 14.60	SIGN FRAME REQUIRED	REMARKS	SIGN DETAIL LOCATION SHSM	SIGN DETAIL LOCATION SIGN DETAILS SHEET #	SIGN DETAIL LOCATION STANDARD SHEET #
SB WALLINGFORD VT RTE 155							FY-FLUORESCENT YELLOW FYG-FLUORESCENT YELLOW GREEN																			"SHSM"-STANDARD HIGHWAY SIGNS AND MARKINGS BOOK			
SB	0.000	G	VD-024	72	12		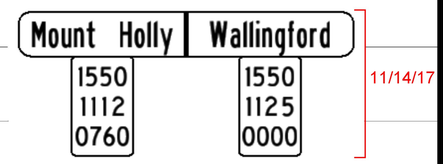 11/14/17	6.00								2		12'-6" 12'-3" X										T-94
		G	VD-700	6	10			0.42																		INSTALL MOUNT HOLLY MILE MARKER ON THE LEFT POST UNDER MOUNT HOLLY			T-44
		G	VD-700	6	10			0.42																		INSTALL WALLINGFORD MILE MARKER ON THE RIGHT POST UNDER WALLINGFORD			T-44
							SHEET TOTALS	6.83	0.00	0	0	0	0	0	0	2		30.0		0	0.0	0.0	0.0	0.0					
								SF	SF	EA	EA	EA	EA	EA	EA	EA		FT		EA	LB	LB	LB	LB					
							TOWN DIRECTIONAL TOTALS	62.8	0.0	3	5	5	22	0	0	14		205.0		0	0.0								

SIGN SUMMARY SHEET

VERMONT AGENCY OF TRANSPORTATION

PROJECT NAME: STATEWIDE-SOUTH REGION
PROJECT NUMBER: STPG SIGN(57)
FILE NAME: z16t041Wallingford155SB.xls
PROJECT MANAGER: D. MUNRO
DESIGNED BY: P. MCKECHNIE
WALLINGFORD VT-155 SB 4
PLOT DATE: 2/27/2017
DRAWN BY: W. GORDON
CHECKED BRZEZOWSK
SHEET 263 OF 264