DIRECTION	MILEPOINT	LOCATION CODE (SHEET 4)	SIGN CODE	WIDTH (IN)	HEIGHT (IN)	SHEETING REMARKS	SIGN LEGEND	NEW SIGNS "A"	NEW SIGNS "B"	EXISTING SIGNS RETAIN	EXISTING SIGNS SALVAGE FROM	EXISTING SIGNS SALVAGE TO	EXISTING SIGNS REMOVE	EXIST POST RETAIN	EXIST POST REMOVE	NUMBER OF NEW POSTS	SQUARE STEEL (IN) 1.75 (LB / FT) 1.88	SQUARE STEEL (IN) 2.00 (LB / FT) 2.42	SQUARE STEEL (IN) 2.50 (LB / FT) 3.35	FOUNDATION	TUBULAR STEEL Ø (IN) 3.00 (LB / FT) 7.60	TUBULAR STEEL Ø (IN) 3.50 (LB / FT) 9.00	TUBULAR STEEL Ø (IN) 4.00 (LB / FT) 10.80	TUBULAR STEEL Ø (IN) 5.00 (LB / FT) 14.60	SIGN FRAME REQUIRED	REMARKS	SIGN DETAIL LOCATION SHSM	SIGN DETAIL LOCATION SIGN DETAILS SHEET #	SIGN DETAIL LOCATION STANDARD SHEET #
NB CLARENDON VT ROUTE 7B							FY-FLUORESCENT YELLOW FYG-FLUORESCENT YELLOW GREEN																				"SHSM"-STANDARD HIGHWAY SIGNS AND MARKINGS BOOK			
NB	0.000	C	VD-024	72	10		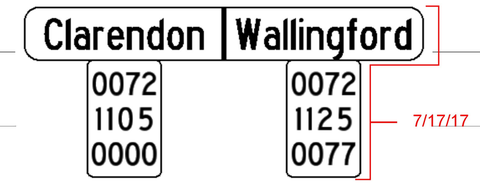	5.00								2		11'-3" 11'-0" X								INSTALL THIS ASSEMBLY CENTERED IN THE SAME POSITION AS THE EXISTING			T-94
		C	VD-700	6	10			0.42																		INSTALL CLARENDON MILE MARKER ON THE LEFT POST UNDER CLARENDON			T-44
		C	VD-700	6	10			0.42																		INSTALL WALLINGFORD MILE MARKER ON THE RIGHT POST UNDER WALLINGFORD			T-44
NB	0.156	A					HIDDEN TRUCK ENTRANCE LEFT						1		X														
NB	0.194	A	VW-133L	30	30		7/18/17	6.25								1		10'-3" X								INSTALL 200' UPSTATION FROM EXISTING SIGN AT MP 0.156			T-81
NB	0.211	A	W8-1				BUMP			1				X												SEASONAL SIGN			
NB	0.696	A	W1-1L	30	30	FY	7/18/17	6.25								1		14'-9" X								INSTALL 160' UPSTATION FROM UTILITY POLE #42/8/58 AT MP 0.666 NB	X		
		A	W13-1P	18	18	FY		2.25																			X		
NB	0.821	A	W3-1				7/18/17						1	X															
		A	W3-1	30	30			6.25																		INSTALL ON RETAINED POST **NOTE: PROJECT SUSPENDS HERE AT JUNCTION WITH U.S. 7**	X		
NB	0.946	C					LOWER CLARENDON GORGE STATE PARK			1				X												**NOTE: PROJECT RESUMES HERE AT JUNCTION WITH U.S. 7**			
		C					AREA CLOSED FROM DUSK UNTIL DAWN			1																			
NB	0.956	C	VR-017	24	30		7/18/17	5.00								1		12'-0" X								INSTALL SIGN ON THE EAST SOUTH SIDE OF TH PER T-56			T-70
NB	0.961	D	R1-1				STOP						1	~~X~~	X														
		C	VR-017				LLL 24,000 LBS						1																
SIGN SUMMARY SHEET							SHEET TOTALS	31.83	0.00	3	0	0	4	0	0	5		75.0		0	0.0	0.0	0.0	0.0				
								SF	SF	EA	EA	EA	EA	EA	EA	EA		FT		EA	LB	LB	LB	LB				
VERMONT AGENCY OF TRANSPORTATION							TOWN DIRECTIONAL TOTALS	202.9	0.0	5	0	0	40	0	0	27		370.0		2	288.0							

PROJECT NAME: **STATEWIDE-SOUTH REGION**
PROJECT NUMBER: **STPG SIGN(57)**
FILE NAME: **z16t041Clarendon7B NB.xls** PLOT DATE: **2/27/2017**
PROJECT MANAGER: **D. MUNRO** DRAWN BY: **W. GORDON**
DESIGNED BY: **P. MCKECHNIE** CHECKED **BRZEZOWSK**
CLARENDON VT-7B NB 1 SHEET **20** OF **264**