DIRECTION	MILEPOINT	LOCATION CODE (SHEET 4)	SIGN CODE	WIDTH (IN)	HEIGHT (IN)	SHEETING REMARKS	SIGN LEGEND	NEW SIGNS "A"	NEW SIGNS "B"	EXISTING SIGNS RETAIN	EXISTING SIGNS SALVAGE FROM	EXISTING SIGNS SALVAGE TO	EXISTING SIGNS REMOVE	EXIST POST RETAIN	EXIST POST REMOVE	NUMBER OF NEW POSTS	SQUARE STEEL (IN) 1.75 (LB / FT) 1.88	SQUARE STEEL (IN) 2.00 (LB / FT) 2.42	SQUARE STEEL (IN) 2.50 (LB / FT) 3.35	TUBULAR STEEL Ø (IN) FOUNDATION	TUBULAR STEEL Ø (IN) 3.00 (LB / FT) 7.60	TUBULAR STEEL Ø (IN) 3.50 (LB / FT) 9.00	TUBULAR STEEL Ø (IN) 4.00 (LB / FT) 10.80	TUBULAR STEEL Ø (IN) 5.00 (LB / FT) 14.60	SIGN FRAME REQUIRED	REMARKS	SIGN DETAIL LOCATION SHSM	SIGN DETAIL LOCATION SIGN DETAILS SHEET #	SIGN DETAIL LOCATION STANDARD SHEET #
SB CLARENDON VT ROUTE 7B							FY-FLUORESCENT YELLOW FYG-FLUORESCENT YELLOW GREEN																			"SHSM"-STANDARD HIGHWAY SIGNS AND MARKINGS BOOK			
		F	M6-3				UP ARROW						1																
		F	M3-1				NORTH						1																
		F	VM1-5				VERMONT 103						1																
		F	M6-1R				RIGHT ARROW						1																
		F	M3-3	24	12			2.00								2				2		16'-9" 16'-3" 279			3C	SOUTH, GREEN ON WHITE	X		
		F	VM1-5	30	24			5.00																					E-136
		F	M6-1L	21	15		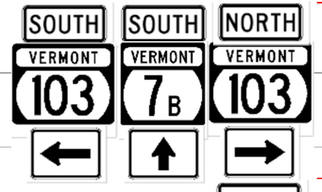 11/27/17	2.19																ARROW,GREEN ON WHITE	X		
		F	M3-3	24	12			2.00																			SOUTH, GREEN ON WHITE	X		
		F	VM1-5	24	24		4/9/18	4.00																					E-136
		F	M6-3	21	15		11/27/17	2.19																			ARROW, GREEN ON WHITE	X		
		F	M3-1	24	12			2.00																			NORTH, GREEN ON WHITE	X		
		F	VM1-5	30	24			5.00																					E-136
		F	M6-1R	21	15			2.19																			ARROW, GREEN ON WHITE	X		
		F	M6-1L	24	12			2.00																			TO, BLACK ON WHITE INSTALL ON RIGHT POST	X		
		F	M1-4	24	24			4.00																			INSTALL ON RIGHT POST	X		
							SHEET TOTALS	32.56	0.00	0	0	0	4	0	0	2	0.0			2	0.0	279.0	0.0	0.0					
								SF	SF	EA	EA	EA	EA	EA	EA	EA	FT			EA	LB	LB	LB	LB					
							TOWN DIRECTIONAL TOTALS	154.3	0.0	1	0	0	37	0	0	17	220.0			2	279.0								

SIGN SUMMARY SHEET

VERMONT AGENCY OF TRANSPORTATION

PROJECT NAME: **STATEWIDE-SOUTH REGION**
PROJECT NUMBER: **STPG SIGN(57)**

FILE NAME: **z16t041Clarendon7B SB.xls** PLOT DATE: **2/27/2017**
PROJECT MANAGER: **D. MUNRO** DRAWN BY: **W. GORDON**
DESIGNED BY: **P. MCKECHNIE** CHECKED **BRZEZOWSK**
CLARENDON VT-7B SB 3 SHEET **29** OF **264**