DIRECTION	MILEPOINT	LOCATION CODE (SHEET 4)	SIGN CODE	WIDTH (IN)	HEIGHT (IN)	SHEETING REMARKS	SIGN LEGEND	NEW SIGNS "A"	NEW SIGNS "B"	EXISTING SIGNS RETAIN	EXISTING SIGNS SALVAGE FROM	EXISTING SIGNS SALVAGE TO	EXISTING SIGNS REMOVE	EXIST POST RETAIN	EXIST POST REMOVE	NUMBER OF NEW POSTS	SQUARE STEEL (IN) 1.75 (LB / FT) 1.88	SQUARE STEEL (IN) 2.00 (LB / FT) 2.42	SQUARE STEEL (IN) 2.50 (LB / FT) 3.35	FOUNDATION	TUBULAR STEEL Ø (IN) 3.00 (LB / FT) 7.60	TUBULAR STEEL Ø (IN) 3.50 (LB / FT) 9.00	TUBULAR STEEL Ø (IN) 4.00 (LB / FT) 10.80	TUBULAR STEEL Ø (IN) 5.00 (LB / FT) 14.60	SIGN FRAME REQUIRED	REMARKS	SIGN DETAIL LOCATION SHSM	SIGN DETAIL LOCATION SIGN DETAILS SHEET #	SIGN DETAIL LOCATION STANDARD SHEET #
SB LUDLOW VT ROUTE 103							FY-FLUORESCENT YELLOW FYG-FLUORESCENT YELLOW GREEN																			"SHSM"-STANDARD HIGHWAY SIGNS AND MARKINGS BOOK			
SB	5.604	F	VW-092				UNSAFE TO PASS			1				X															
SB	5.280	F	VW-092				UNSAFE TO PASS			1				X															
SB	5.126	F	VD-062B				OFFICIAL BUSINESS DIRECTIONAL SIGN			1				X												Coleman Brook Tavern			
		F	VD-062B				OFFICIAL BUSINESS DIRECTIONAL SIGN			1																Jackson Gore Inn			
		F	VD-062B				OFFICIAL BUSINESS DIRECTIONAL SIGN			1																Jackson Gore Real Estate			
SB	4.694	F	R2-1				8/28/17						1		X														
		F	R2-1	24	30			5.00								1		13'-3" X									X		
SB	4.522	F	W6-1				DIVIDED HIGHWAY						1		X														
SB	4.487	F	W2-7L				INTERSECTION WARNING SIGN						1		X														
		F	W16-8				<--BUTTERMILK FALLS RD						1																
		F	W16-8				OKEMO RIDGE RD -->						1																
		F	W2-1MdL	30	30		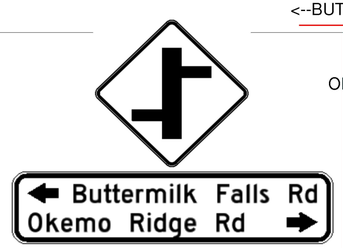 8/28/17	6.25								2		14'-6" 13'-9" X										2	
		F	W16-8aP	64	15			6.67																				5	
SB	4.448	F	VD-062B				8/28/17 OFFICIAL BUSINESS DIRECTIONAL SIGN			1				X											Inn at Water's Edge, VT 100 no.			
SB	4.390	F	W6-1	36	36			9.00								2		15'-3" 14'-6" X								INSTALL SIGN ±245' DOWNSTATION FROM EXISTING SIGN AT MP 4.436 SB	X		
							SHEET TOTALS	26.92	0.00	6	0	0	5	0	0	5		75.0		0	0.0	0.0	0.0	0.0					
								SF	SF	EA	EA	EA	EA	EA	EA	EA		FT		EA	LB	LB	LB	LB					
							TOWN DIRECTIONAL TOTALS	502.1	0.0	48	5	5	120	0	0	62		870.0		2	217.0								

SIGN SUMMARY SHEET

VERMONT AGENCY OF TRANSPORTATION

PROJECT NAME: STATEWIDE-SOUTH REGION
PROJECT NUMBER: STPG SIGN(57)

FILE NAME: z16t041Ludlow103 SB.xls
PROJECT MANAGER: D. MUNRO
DESIGNED BY: P. MCKECHNIE
LUDLOW VT-103 SB 1

PLOT DATE: 2/27/2017
DRAWN BY: W. GORDON
CHECKED BRZEZOWSK