DIRECTION	MILEPOINT	LOCATION CODE (SHEET 4)	SIGN CODE	WIDTH (IN)	HEIGHT (IN)	SHEETING REMARKS	SIGN LEGEND	NEW SIGNS "A"	NEW SIGNS "B"	EXISTING SIGNS RETAIN	EXISTING SIGNS SALVAGE FROM	EXISTING SIGNS SALVAGE TO	EXISTING SIGNS REMOVE	EXIST POST RETAIN	EXIST POST REMOVE	NUMBER OF NEW POSTS	SQUARE STEEL (IN) 1.75 (LB / FT) 1.88	SQUARE STEEL (IN) 2.00 (LB / FT) 2.42	SQUARE STEEL (IN) 2.50 (LB / FT) 3.35	FOUNDATION	TUBULAR STEEL Ø (IN) 3.00 (LB / FT) 7.60	TUBULAR STEEL Ø (IN) 3.50 (LB / FT) 9.00	TUBULAR STEEL Ø (IN) 4.00 (LB / FT) 10.80	TUBULAR STEEL Ø (IN) 5.00 (LB / FT) 14.60	SIGN FRAME REQUIRED	REMARKS	SIGN DETAIL LOCATION SHSM	SIGN DETAIL LOCATION SIGN DETAILS SHEET #	SIGN DETAIL LOCATION STANDARD SHEET #
NB MOUNT HOLLY VT ROUTE 103							FY-FLUORESCENT YELLOW FYG-FLUORESCENT YELLOW GREEN																			"SHSM"-STANDARD HIGHWAY SIGNS AND MARKINGS BOOK			
NB	1.053	B	OM3-L				9/5/17						1		X														
		B	OM3-L	12	36			3.00								1		10'-6" X										X		
NB	1.377	A	VD-062B				OFFICIAL BUSINESS DIRECTIONAL SIGN			1				X													Crowley Cheese Factory			
NB	1.595	A	VD-701				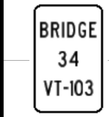 9/5/17						1	X																
		A	VD-701	6	10			0.42																			INSTALL ON RETAINED POST			T-42
NB	1.598	AB	D3-1				8/21/17 Sawyer Hill Rd TH 45					1				2		10'-6" 10'-6" X								SAWYER HILL RD (TH-45) INSTALL 15' DOWNSTATION FROM EXISTING SIGN AT MP 1.614 NB			
NB	1.601	AB	D3-1				Sawyer Hill Rd TH 45				1		1		X														
NB	1.601	C	VR-017				8/18/17						1	X																
		C	VR-017	24	30			5.00																			INSTALL NEW SIGN ON RETAINED POST			T-70
NB	1.614	D	R1-1				STOP			1				X															
NB	1.677	A	R4-6				TRUCK LANE 500 FEET						1		X														
NB	1.692	C	VR-017				8/16/17						1	X													SHUNPIKE RD (TH-57)			
		C	VR-017	24	30			5.00																			INSTALL NEW SIGN ON RETAINED POST			T-70
NB	1.692	AB	D3-1	68	12		8/16/17	5.67								2		11'-6" 11'-3" X								INSTALL INDEPENDENTLY ON TWO POSTS ON THE LEGAL LOAD SIDE OF THE INTERSECTION		7	
							SHEET TOTALS	19.08	0.00	2	1	1	6	0	0	5		75.0		0	0.0	0.0	0.0	0.0					
								SF	SF	EA	EA	EA	EA	EA	EA	EA		FT		EA	LB	LB	LB	LB					
							TOWN DIRECTIONAL TOTALS	349.8	0.0	22	7	7	78	0	0	48		680.0		0	0.0								

SIGN SUMMARY SHEET

VERMONT AGENCY OF TRANSPORTATION

PROJECT NAME: **STATEWIDE-SOUTH REGION**
PROJECT NUMBER: **STPG SIGN(57)**
FILE NAME: **z16t041Mt Hollv103 NB.xls**
PROJECT MANAGER: **D. MUNRO**
DESIGNED BY: **P. MCKECHNIE**
MOUNT HOLLY VT-103 NB 2
PLOT DATE: **2/27/2017**
DRAWN BY: **W. GORDON**
CHECKED **BRZEZOWSK**
SHEET **84** OF **264**