DIRECTION	MILEPOINT	LOCATION CODE (SHEET 4)	SIGN CODE	WIDTH (IN)	HEIGHT (IN)	SHEETING REMARKS	SIGN LEGEND	NEW SIGNS "A"	NEW SIGNS "B"	EXISTING SIGNS RETAIN	EXISTING SIGNS SALVAGE FROM	EXISTING SIGNS SALVAGE TO	EXISTING SIGNS REMOVE	EXIST POST RETAIN	EXIST POST REMOVE	NUMBER OF NEW POSTS	SQUARE STEEL (IN) 1.75 (LB / FT) 1.88	SQUARE STEEL (IN) 2.00 (LB / FT) 2.42	SQUARE STEEL (IN) 2.50 (LB / FT) 3.35	TUBULAR STEEL Ø (IN) FOUNDATION	TUBULAR STEEL Ø (IN) 3.00 (LB / FT) 7.60	TUBULAR STEEL Ø (IN) 3.50 (LB / FT) 9.00	TUBULAR STEEL Ø (IN) 4.00 (LB / FT) 10.80	TUBULAR STEEL Ø (IN) 5.00 (LB / FT) 14.60	SIGN FRAME REQUIRED	REMARKS	SIGN DETAIL LOCATION SHSM	SIGN DETAIL LOCATION SIGN DETAILS SHEET #	SIGN DETAIL LOCATION STANDARD SHEET #
NB MOUNT HOLLY VT ROUTE 103							FY-FLUORESCENT YELLOW FYG-FLUORESCENT YELLOW GREEN																			"SHSM"-STANDARD HIGHWAY SIGNS AND MARKINGS BOOK			
		A	S3-1	36	36	FYG	8/24/17	9.00								2	15'-6" 15'-0" X										X		
		A	W16-2P	24	18	FYG		3.00																		INSTALL ON LEFT POST	X		
NB	6.315	A	W2-2	30	30		12/1/17	6.25								1	13'-0" X									INSTALL ±325 FT UPSTATION OF EXISTING SIGN AT MP 6.254 NB	X		
		A	W16-8P	24	8		Parker Rd Packer Rd 4/9/18	1.33																				5	
NB	6.372	A	VW-133R	30	30		8/24/17	6.25								1	14'-0" X									INSTALL ±625 FT UPSTATION OF EXISTING SIGN AT MP 6.254 NB			T-81
NB	6.424	C	VR-017				8/17/17						1	X												PACKER RD (TH-18)			
		C	VR-017	24	30			5.00																		INSTALL ON RETAINED POST			T-70
NB	6.432	AB	D3-1				TH18 PACKER RD			1				X															
NB	6.432	D	R1-1				STOP						1		X														
		C	VD-700				MILE MARKER 1030 / 1112 / 0645				1		1																
		D	R1-1	30	30		8/17/17	6.25								1	12'-9" X									INSTALL SIGN POST A MIN. 8 FT FROM OTHER SIGN POSTS	X		
		C	VD-700				MILE MARKER 1030 / 1112 / 0645					1														INSTALL BACK TO BACK ON STOP SIGN POST			
NB	7.100	A	VD-701				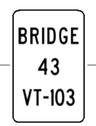 8/24/17						1	X															
		A	VD-701	6	10		8/24/17	0.42																		INSTALL ON RETAINED POST			T-42
NB	7.314	A	R2-1	24	30			5.00																		INSTALL ON EXISTING EMPTY POST 450' DOWNSTATION FROM EXISTING SIGN AT MP 7.394 NB	X		
							SHEET TOTALS	42.50 SF	0.00 SF	1 EA	1 EA	1 EA	4 EA	0 EA	0 EA	5 EA	75.0 FT		0 EA	0.0 LB	0.0 LB	0.0 LB	0.0 LB			
							TOWN DIRECTIONAL TOTALS	349.8	0.0	22	7	7	78	0	0	48	680.0		0	0.0						

SIGN SUMMARY SHEET

VERMONT AGENCY OF TRANSPORTATION

PROJECT NAME: **STATEWIDE-SOUTH REGION**
PROJECT NUMBER: **STPG SIGN(57)**
FILE NAME: **z16t041Mt Hollv103 NB.xls**
PROJECT MANAGER: **D. MUNRO**
DESIGNED BY: **P. MCKECHNIE**
MOUNT HOLLY VT-103 NB 10
PLOT DATE: **2/27/2017**
DRAWN BY: **W. GORDON**
CHECKED **BRZEZOWSK**
SHEET **92** OF **264**