DIRECTION	MILEPOINT	LOCATION CODE (SHEET 4)	SIGN CODE	WIDTH (IN)	HEIGHT (IN)	SHEETING REMARKS	SIGN LEGEND	NEW SIGNS "A"	NEW SIGNS "B"	EXISTING SIGNS RETAIN	EXISTING SIGNS SALVAGE FROM	EXISTING SIGNS SALVAGE TO	EXISTING SIGNS REMOVE	EXIST POST RETAIN	EXIST POST REMOVE	NUMBER OF NEW POSTS	SQUARE STEEL (IN) 1.75 (LB / FT) 1.88	SQUARE STEEL (IN) 2.00 (LB / FT) 2.42	SQUARE STEEL (IN) 2.50 (LB / FT) 3.35	FOUNDATION	TUBULAR STEEL Ø (IN) 3.00 (LB / FT) 7.60	TUBULAR STEEL Ø (IN) 3.50 (LB / FT) 9.00	TUBULAR STEEL Ø (IN) 4.00 (LB / FT) 10.80	TUBULAR STEEL Ø (IN) 5.00 (LB / FT) 14.60	SIGN FRAME REQUIRED	REMARKS	SIGN DETAIL LOCATION SHSM	SIGN DETAIL LOCATION SIGN DETAILS SHEET #	SIGN DETAIL LOCATION STANDARD SHEET #
SB WALLINGFORD VT RTE 103							FY-FLUORESCENT YELLOW FYG-FLUORESCENT YELLOW GREEN																			"SHSM"-STANDARD HIGHWAY SIGNS AND MARKINGS BOOK			
SB	0.281	F	VD1-1A				(UP TO THE LEFT) MOUNT HOLLY 2						1	X															
		F	VD1-1A				(UP TO THE LEFT) LUDLOW 11						1																
		F	VD1-1A				WALLINGFORD 6 (UP TO THE RIGHT)						1																
		F	VD1-1A				WESTON 14 (UP TO THE RIGHT)						1																
		F	VD1-1A	72	12		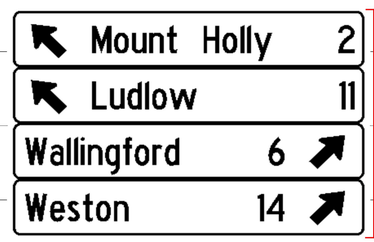	6.00																	INSTALL ON RETAINED POSTS			T-93
		F	VD1-1A	72	12			6.00																				T-93
		F	VD1-1A	72	12			6.00																				T-93
		F	VD1-1A	72	12			6.00																				T-93
SB	0.241	F	M3-3				SOUTH						1	X															
		F	VM1-5				VERMONT 103						1																
		F	M6-2L				UP AND TO THE LEFT ARROW						1																
		F	M3-3				SOUTH						1																
		F	VM1-5				VERMONT 155						1																
		F	M6-2R				UP AND TO THE RIGHT ARROW						1																
		F	M4-5				TO						1																
							SHEET TOTALS	24.00	0.00	0	0	0	11	0	0	0	0.0			0	0.0	0.0	0.0	0.0					
								SF	SF	EA	EA	EA	EA	EA	EA	EA	FT			EA	LB	LB	LB	LB					
							TOWN DIRECTIONAL TOTALS	163.5	0.0	7	0	0	40	0	0	21	305.0			0	0.0								

4/9/18

SIGN SUMMARY SHEET

VERMONT AGENCY OF TRANSPORTATION

PROJECT NAME: STATEWIDE-SOUTH REGION
PROJECT NUMBER: STPG SIGN(57)
FILE NAME: z16t041Wallingford103 SB.xls
PROJECT MANAGER: D. MUNRO
DESIGNED BY: P. MCKECHNIE
WALLINGFORD VT-103 SB 5
PLOT DATE: 2/27/2017
DRAWN BY: W. GORDON
CHECKED BY: BRZEZOWSK
SHEET 120 OF 264