DIRECTION	MILEPOINT	LOCATION CODE (SHEET 4)	SIGN CODE	WIDTH (IN)	HEIGHT (IN)	SHEETING REMARKS	SIGN LEGEND	NEW SIGNS "A"	NEW SIGNS "B"	EXISTING SIGNS RETAIN	EXISTING SIGNS SALVAGE FROM	EXISTING SIGNS SALVAGE TO	EXISTING SIGNS REMOVE	EXIST POST RETAIN	EXIST POST REMOVE	NUMBER OF NEW POSTS	SQUARE STEEL (IN) 1.75 (LB / FT) 1.88	SQUARE STEEL (IN) 2.00 (LB / FT) 2.42	SQUARE STEEL (IN) 2.50 (LB / FT) 3.35	FOUNDATION	TUBULAR STEEL Ø (IN) 3.00 (LB / FT) 7.60	TUBULAR STEEL Ø (IN) 3.50 (LB / FT) 9.00	TUBULAR STEEL Ø (IN) 4.00 (LB / FT) 10.80	TUBULAR STEEL Ø (IN) 5.00 (LB / FT) 14.60	SIGN FRAME REQUIRED	REMARKS	SIGN DETAIL LOCATION SHSM	SIGN DETAIL LOCATION SIGN DETAILS SHEET #	SIGN DETAIL LOCATION STANDARD SHEET #
NB BRATTLEBORO VT ROUTE 142							FY-FLUORESCENT YELLOW FYG-FLUORESCENT YELLOW GREEN																			"SHSM"-STANDARD HIGHWAY SIGNS AND MARKINGS BOOK			
		A	VM5-1	30	24			5.00																					E-136I
NB	2.039	A					<-- GUILFORD 4						1		X														
		A					<-- MANCHESTER 46						1																	
		A					HINSDALE NH -->						1																	
		A	VD1-1A	72	12		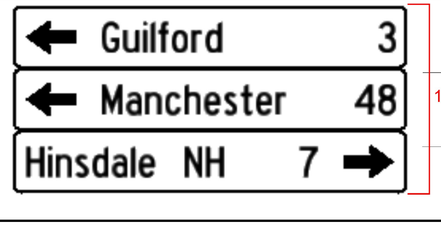 11/9/17	6.00								2		14'-0" 13'-9" X							PROVIDE 7' MINIMUM CLEAR HEIGHT			T-93
		A	VD1-1A	72	12			6.00																					T-93
		A	VD1-1A	72	12			6.00																					T-93
NB	2.055	A	W3-3				SIGNAL AHEAD						1		X														
NB	2.065	A	W3-3	30	30		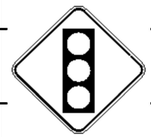 11/9/17	6.25								1		13'-9" X									INSTALL SIGN ±50' UPSTATION FROM EXISTING SIGN AT MP 2.055 NB	X		
NB	2.104	A	M3-1	24	12		(SEE IMAGE ON NEXT PAGE)	2.00								2				2	15'-9" 15'-6" 236				3B	INSTALL SIGN ASSEMBLY ±25' DOWNSTATION FROM EXISTING SIGN AT MP 2.109 NB IN MULCH AREA, UPSTATION FROM GRANITE WALKING PATH. PROVIDE 7' MINIMUM CLEAR HEIGHT	X		
		A	M1-4	24	24			4.00																				X		
		A	M6-1	21	15			2.19																			SOUTH, BLACK ON WHITE ARROW, BLACK ON WHITE	X		
		A	M4-5	24	12			2.00																			TO, (INTERSTATE) WHITE ON BLUE	X		
		A	M1-1	24	24			4.00																				X		
		A	M6-1	21	15			2.19																			ARROW, (INTERSTATE) WHITE ON BLUE	X		
							SHEET TOTALS	45.63	0.00	0	0	0	4	0	0	5		45.0		2	236.0	0.0	0.0	0.0				
								SF	SF	EA	EA	EA	EA	EA	EA	EA		FT		EA	LB	LB	LB	LB				
							TOWN DIRECTIONAL TOTALS	209.8	0.0	7	4	4	50	0	0	30		420.0		2	236.0							

SIGN SUMMARY SHEET

VERMONT AGENCY OF TRANSPORTATION

PROJECT NAME: **STATEWIDE-SOUTH REGION**
PROJECT NUMBER: **STPG SIGN(57)**
FILE NAME: **z16t041Brattleboro142 NB.xls** PLOT DATE: **2/27/2017**
PROJECT MANAGER: **D. MUNRO** DRAWN BY: **W. GORDON**
DESIGNED BY: **P. MCKECHNIE** CHECKED **BRZEZOWSK**
BRATTLEBORO VT-142 NB 6 SHEET **189** OF **264**