DIRECTION	MILEPOINT	LOCATION CODE (SHEET 4)	SIGN CODE	WIDTH (IN)	HEIGHT (IN)	SHEETING REMARKS	SIGN LEGEND	NEW SIGNS "A"	NEW SIGNS "B"	EXISTING SIGNS RETAIN	EXISTING SIGNS SALVAGE FROM	EXISTING SIGNS SALVAGE TO	EXISTING SIGNS REMOVE	EXIST POST RETAIN	EXIST POST REMOVE	NUMBER OF NEW POSTS	SQUARE STEEL (IN) 1.75 (LB / FT) 1.88	SQUARE STEEL (IN) 2.00 (LB / FT) 2.42	SQUARE STEEL (IN) 2.50 (LB / FT) 3.35	FOUNDATION	TUBULAR STEEL Ø (IN) 3.00 (LB / FT) 7.60	TUBULAR STEEL Ø (IN) 3.50 (LB / FT) 9.00	TUBULAR STEEL Ø (IN) 4.00 (LB / FT) 10.80	TUBULAR STEEL Ø (IN) 5.00 (LB / FT) 14.60	SIGN FRAME REQUIRED	REMARKS	SIGN DETAIL LOCATION SHSM	SIGN DETAIL LOCATION SIGN DETAILS SHEET #	SIGN DETAIL LOCATION STANDARD SHEET #
NB BRATTLEBORO VT ROUTE 142							FY-FLUORESCENT YELLOW FYG-FLUORESCENT YELLOW GREEN																				"SHSM"-STANDARD HIGHWAY SIGNS AND MARKINGS BOOK			
		A	M3-1	24	12		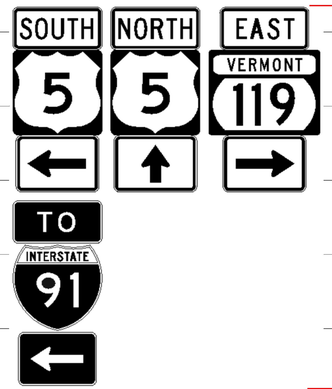 4/9/18	2.00																NORTH, BLACK ON WHITE	X		
		A	M1-4	24	24			4.00																				X		
		A	M6-3	21	15			2.19																			ARROW, BLACK ON WHITE	X		
		A	M3-2	24	12			2.00																			EAST, GREEN ON WHITE INSTALL ON RIGHT POST	X		
		A	VM5-1	24	24			4.00																						E-136
		A	M6-1	21	15			2.19																			ARROW, GREEN ON WHITE	X		
NB	2.109	A	M4-5				TO						1		X														
		A	M1-4				US ROUTE 5						1																
		A	M6-1				LEFT ARROW						1																
		A	M1-1				INTERSTATE 91						1																
		A	M6-1				LEFT ARROW						1																
		A	M3-2				EAST						1																
		A	VM5-1				VERMONT 119						1																
		A	M6-1R				RIGHT ARROW						1																
SIGN SUMMARY SHEET							SHEET TOTALS	16.38	0.00	0	0	0	8	0	0	0		0.0		0	0.0	0.0	0.0	0.0					
								SF	SF	EA	EA	EA	EA	EA	EA	EA		FT		EA	LB	LB	LB	LB					
VERMONT AGENCY OF TRANSPORTATION							TOWN DIRECTIONAL TOTALS	209.8	0.0	7	4	4	50	0	0	30		420.0		2	236.0								

PROJECT NAME: **STATEWIDE-SOUTH REGION**
PROJECT NUMBER: **STPG SIGN(57)**
FILE NAME: **z16t041Brattleboro142 NB.xls** PLOT DATE: **2/27/2017**
PROJECT MANAGER: **D. MUNRO** DRAWN BY: **W. GORDON**
DESIGNED BY: **P. MCKECHNIE** CHECKED **BRZEZOWSK**
BRATTLEBORO VT-142 NB 7 SHEET **190** OF **264**