NB BRATTLEBORO VT ROUTE 142

FY-FLUORESCENT YELLOW
FYG-FLUORESCENT YELLOW GREEN

DIRECTION	MILEPOINT	LOCATION CODE (SHEET 4)	SIGN CODE	WIDTH (IN)	HEIGHT (IN)	SHEETING REMARKS	SIGN LEGEND	NEW SIGNS "A"	NEW SIGNS "B"	EXISTING SIGNS RETAIN	EXISTING SIGNS SALVAGE FROM	EXISTING SIGNS SALVAGE TO	EXISTING SIGNS REMOVE	EXIST POST RETAIN	EXIST POST REMOVE	NUMBER OF NEW POSTS	SQUARE STEEL (IN) 1.75 (LB / FT) 1.88	SQUARE STEEL (IN) 2.00 (LB / FT) 2.42	SQUARE STEEL (IN) 2.50 (LB / FT) 3.35	FOUNDATION	TUBULAR STEEL Ø (IN) 3.00 (LB / FT) 7.60	TUBULAR STEEL Ø (IN) 3.50 (LB / FT) 9.00	TUBULAR STEEL Ø (IN) 4.00 (LB / FT) 10.80	TUBULAR STEEL Ø (IN) 5.00 (LB / FT) 14.60	SIGN FRAME REQUIRED	REMARKS	SIGN DETAIL LOCATION SHSM	SIGN DETAIL LOCATION SIGN DETAILS SHEET #	SIGN DETAIL LOCATION STANDARD SHEET #
NB	2.131	A					11/13/17 LANE ASSIGNMENT						1		X														
		A	VR-922	36	30			7.50								1		11'-0" X								PROVIDE 7' MINIMUM CLEAR HEIGHT			E-145A
NB	2.139	A					LANE ASSIGNMENT						1		X														
		A	W10-4R				HIGHWAY-RAIL GRADE CROSSING ADVANCE WARNING						1																
		A	W10-2R	36	36		11/13/17	9.00								2		13'-6" 11'-0" X								PROVIDE 7' MINIMUM CLEAR HEIGHT	X		
NB	2.140	AB	D3-1				Bridge St						1		X														
		CD	D3-1				Vernon St						1																
		A					NO RIGHT TURN ON RED						1																
		AB	D3-1	42	12		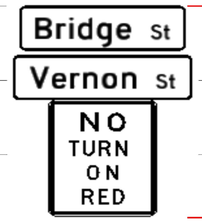 11/13/17	3.50								1		15'-0" X								INSTALL NEW POST IN SAME LOCATION BEHIND SIDEWALK. PROVIDE 7' MIN. CLEAR HEIGHT.		8	
		CD	D3-1	42	12			3.50																		INSTALL ON TOP OF VERNON ST SIGN WITH 12" BRACKET		8	
		A	R10-11a	24	30			5.00																		INSTALL ON TOP OF POST WITH 12" BRACKET	X		

SIGN SUMMARY SHEET

VERMONT AGENCY OF TRANSPORTATION

SHEET TOTALS	28.50	0.00	0	0	0	6	0	0	4		60.0		0	0.0	0.0	0.0	0.0				
	SF	SF	EA	EA	EA	EA	EA	EA	EA		FT		EA	LB	LB	LB	LB				
TOWN DIRECTIONAL TOTALS	209.8	0.0	7	4	4	50	0	0	30		420.0		2	236.0							

PROJECT NAME: STATEWIDE-SOUTH REGION
PROJECT NUMBER: STPG SIGN(57)
FILE NAME: z16t041Brattleboro142 NB.xls
PROJECT MANAGER: D. MUNRO
DESIGNED BY: P. MCKECHNIE
BRATTLEBORO VT-142 NB 8
PLOT DATE: 2/27/2017
DRAWN BY: W. GORDON
CHECKED BRZEZOWSK
SHEET 191 OF 264