DIRECTION	MILEPOINT	LOCATION CODE (SHEET 4)	SIGN CODE	WIDTH (IN)	HEIGHT (IN)	SHEETING REMARKS	SIGN LEGEND	NEW SIGNS "A"	NEW SIGNS "B"	EXISTING SIGNS RETAIN	EXISTING SIGNS SALVAGE FROM	EXISTING SIGNS SALVAGE TO	EXISTING SIGNS REMOVE	EXIST POST RETAIN	EXIST POST REMOVE	NUMBER OF NEW POSTS	SQUARE STEEL (IN) 1.75 (LB / FT) 1.88	SQUARE STEEL (IN) 2.00 (LB / FT) 2.42	SQUARE STEEL (IN) 2.50 (LB / FT) 3.35	FOUNDATION	TUBULAR STEEL Ø (IN) 3.00 (LB / FT) 7.60	TUBULAR STEEL Ø (IN) 3.50 (LB / FT) 9.00	TUBULAR STEEL Ø (IN) 4.00 (LB / FT) 10.80	TUBULAR STEEL Ø (IN) 5.00 (LB / FT) 14.60	SIGN FRAME REQUIRED	REMARKS	SIGN DETAIL LOCATION SHSM	SIGN DETAIL LOCATION SIGN DETAILS SHEET #	SIGN DETAIL LOCATION STANDARD SHEET #
SB BRATTLEBORO VT ROUTE 142							FY-FLUORESCENT YELLOW FYG-FLUORESCENT YELLOW GREEN																			"SHSM"-STANDARD HIGHWAY SIGNS AND MARKINGS BOOK			
SB	1.510	F	VD2-1	72	12		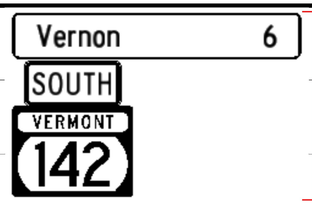 11/8/17	6.00								2		14'-3" 14'-0" X								INSTALL SIGN 25' DOWNSTATION FROM EXISTING SIGN AT MP 1.515 SB			T-93
		F	M3-3	24	12			2.00																		INSTALL ON LEFT POST SOUTH, GREEN ON WHITE	X		
		F	VM5-1	30	24			5.00																		INSTALL ON LEFT POST			E-136
SB	1.415	F	VW-205				11/8/17						1		X															
		F	VW-205	30	30			6.25								1		12'-0" X											T-81
SB	1.255	F	W10-12L				TWO EMPTY POST								X											REMOVE EMPTY POST/POSTS. PAYMENT SHALL BE MADE UNDER ITEM 676.12 REMOVAL OF EXISTING DELINEATORS			
SB	1.235	F	W10-1				TWO EMPTY POST								X											REMOVE EMPTY POST/POSTS. PAYMENT SHALL BE MADE UNDER ITEM 676.12 REMOVAL OF EXISTING DELINEATORS			
SB	1.205	F	R15-1				ONE EMPTY POST								X											REMOVE EMPTY POST/POSTS. PAYMENT SHALL BE MADE UNDER ITEM 676.12 REMOVAL OF EXISTING DELINEATORS			
SB	1.150	F	VW-133L				HIDDEN DRIVE LEFT						1		X														

SIGN SUMMARY SHEET

VERMONT AGENCY OF TRANSPORTATION

SHEET TOTALS	19.25	0.00	0	0	0	2	0	0	3		45.0		0	0.0	0.0	0.0	0.0				
	SF	SF	EA	EA	EA	EA	EA	EA	EA		FT		EA	LB	LB	LB	LB				
TOWN DIRECTIONAL TOTALS	140.3	0.0	1	1	1	25	0	0	23		345.0		0	0.0							

PROJECT NAME: **STATEWIDE-SOUTH REGION**
PROJECT NUMBER: **STPG SIGN(57)**
FILE NAME: **z16t041Brattleboro142 SB.xls** PLOT DATE: **2/27/2017**
PROJECT MANAGER: **D. MUNRO** DRAWN BY: **W. GORDON**
DESIGNED BY: **P. MCKECHNIE** CHECKED **BRZEZOWSK**
BRATTLEBORO VT-142 SB 2 SHEET **193** OF **264**