DIRECTION	MILEPOINT	LOCATION CODE (SHEET 4)	SIGN CODE	WIDTH (IN)	HEIGHT (IN)	SHEETING REMARKS	SIGN LEGEND	NEW SIGNS "A"	NEW SIGNS "B"	EXISTING SIGNS RETAIN	EXISTING SIGNS SALVAGE FROM	EXISTING SIGNS SALVAGE TO	EXISTING SIGNS REMOVE	EXIST POST RETAIN	EXIST POST REMOVE	NUMBER OF NEW POSTS	SQUARE STEEL (IN) (LB / FT) 1.75 / 1.88	2.00 / 2.42	2.50 / 3.35	FOUNDATION	TUBULAR STEEL Ø (IN) (LB / FT) 3.00 / 7.60	3.50 / 9.00	4.00 / 10.80	5.00 / 14.60	SIGN FRAME REQUIRED	REMARKS	SIGN DETAIL LOCATION SHSM	SIGN DETAILS SHEET #	STANDARD SHEET #
EB WALLINGFORD VT RTE 140							FY-FLUORESCENT YELLOW FYG-FLUORESCENT YELLOW GREEN																			"SHSM"-STANDARD HIGHWAY SIGNS AND MARKINGS BOOK			
		A	VW-258P	24	18	FYG		3.00																		INSTALL ON RETAINED POST		5	
EB	3.535	A	R2-1				SPEED LIMIT 40						1		X														
EB	3.610	A	W1-3R				RIGHT REVERSE TURN						1		X														
		A	W13-1P				30 M.P.H.						1																
		A	VD-700				11/4/17 MILE MARKER 1400 / 1125 / 0360				1	1	1			1	8'-0" X									REMOVE AND SALVAGE MILE MARKER ON TO NEW POST AT THE SAME STATION			
EB	3.710	A	W1-2L				LEFT TURN						1		X														
		A	W13-1P				30 MPH PLAQUE						1																
EB	3.750	A	W1-1L	30	30	FY	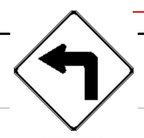 11/4/17	6.25								1		12'-3" X								INSTALL ±210' UPSTATION FROM EXISTING CURVE WARNING AT MP 3.710 NB	X		
		A	W13-1P	18	18	FY		2.25																			X		
EB	3.760	B	W1-8R				11/4/17						1		X															
		B	W1-8R	18	24	FY		3.00								1	12'-6" X										X		
EB	3.775	A	W1-8L	18	24	FY	11/7/17	3.00								1	13'-3" X									INSTALL 80' UPSTATION FROM EXISTING RIGHT CHEVRON AT MP 3.760	X		
EB	3.776	B	W1-8R	18	24	FY	11/7/17	3.00								1	13'-9" X									INSTALL 80' UPSTATION FROM EXISTING RIGHT CHEVRON AT MP 3.760 EB	X		
EB	3.785	A	W1-8L				CHEVRON						1		X														
EB	3.785	B	W1-8R				CHEVRON						1		X														
							SHEET TOTALS	20.50	0.00	0	1	1	9	0	0	5	70.0			0	0.0	0.0	0.0	0.0					
								SF	SF	EA	EA	EA	EA	EA	EA	EA	FT			EA	LB	LB	LB	LB					
							TOWN DIRECTIONAL TOTALS	489.4	0.0	46	4	4	100	0	0	86	1250.0			0	0.0								

SIGN SUMMARY SHEET

VERMONT AGENCY OF TRANSPORTATION

PROJECT NAME: STATEWIDE-SOUTH REGION
PROJECT NUMBER: STPG SIGN(57)

FILE NAME: z16t041Wallingford140EB.xls
PROJECT MANAGER: D. MUNRO
DESIGNED BY: P. MCKECHNIE
WALLINGFORD VT-140 EB 9

PLOT DATE: 2/27/2017
DRAWN BY: W. GORDON
CHECKED BRZEZOWSK