DIRECTION	MILEPOINT	LOCATION CODE (SHEET 4)	SIGN CODE	WIDTH (IN)	HEIGHT (IN)	SHEETING REMARKS	SIGN LEGEND	NEW SIGNS "A"	NEW SIGNS "B"	EXISTING SIGNS RETAIN	EXISTING SIGNS SALVAGE FROM	EXISTING SIGNS SALVAGE TO	EXISTING SIGNS REMOVE	EXIST POST RETAIN	EXIST POST REMOVE	NUMBER OF NEW POSTS	SQUARE STEEL (IN) 1.75 (LB / FT) 1.88	SQUARE STEEL (IN) 2.00 (LB / FT) 2.42	SQUARE STEEL (IN) 2.50 (LB / FT) 3.35	TUBULAR STEEL Ø (IN) FOUNDATION	TUBULAR STEEL Ø (IN) 3.00 (LB / FT) 7.60	TUBULAR STEEL Ø (IN) 3.50 (LB / FT) 9.00	TUBULAR STEEL Ø (IN) 4.00 (LB / FT) 10.80	TUBULAR STEEL Ø (IN) 5.00 (LB / FT) 14.60	SIGN FRAME REQUIRED	REMARKS	SIGN DETAIL LOCATION SHSM	SIGN DETAIL LOCATION SIGN DETAILS SHEET #	SIGN DETAIL LOCATION STANDARD SHEET #
EB WALLINGFORD VT RTE 140							FY-FLUORESCENT YELLOW FYG-FLUORESCENT YELLOW GREEN																				"SHSM"-STANDARD HIGHWAY SIGNS AND MARKINGS BOOK			
EB	6.019	A	W1-1MdL	36	36		11/2/17	9.00								2		13'-9" 12'-6" X									INSTALL ASSEMBLY 100' UPSTATION FROM SIGN AT MP 6.000 EB		2	
		A	W16-8aP	36	8		11/21/17	2.00																				5	
		A	W13-1P	24	24		11/2/17	4.00																			INSTALL ON LEFT POST	X		
EB	6.043	B	D3-1	60	12		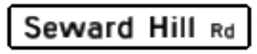 11/1/17	5.00								2		10'-6" 10'-0" X									INSTALL SIGN ±10' UPSTATION FROM EXISTING ARROW SIGN AT MP 6.045 EB		9	
EB	6.045	B	W1-6										1		X															
		B	W1-6	48	24		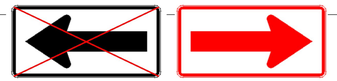 11/1/17	8.00								2		12'-0" 11'-9" X										X		
EB	6.045	CD					SUGAR HILL RD						1		X															
		AB					SEWARDS HILL						1														SEWARD HILL RD (TH-84)			
EB	6.046	C	VR-017	24	30		11/1/17	5.00								1		12'-0" X									SEWARD HILL RD (TH-84) INSTALL SIGN ON NORTH SIDE OF TOWN HIGHWAY			T-70
EB	6.048	C	R1-1	~~30~~	~~30~~			~~6.25~~		1				X		~~1~~		~~X~~									SEWARD HILL RD (TH-84) INSTALL ON SOUTH SIDE OF SEWARD HILL RD. LINE UP SIGN WITH UTILITY POLE ON SOUTH SIDE OF ROAD.	X	EXISTING SIGN IS IN LI NEW CONDITION AND PROPERLY PLACED; WAS RETAINED	
EB	6.050	C	VR-017				LLL 24,000 LBS						1		X												SUGAR HILL RD (TH-6)			
		C	VR-017	24	30		11/1/17	5.00								1		10'-6" X												T-70
EB	6.051	AB	D3-1	56	12		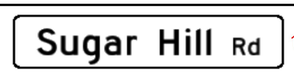 11/2/17	4.67								2		8'-3" 8'-0" X									INSTALL ON LEGAL LOAD SIGN SIDE OF INTERSECTION		9	
EB	6.053	D	R1-1				STOP			1				X																
		C	VD-700				MILE MARKER 1400/1125/0605			1																					
SIGN SUMMARY SHEET							SHEET TOTALS	48.92	0.00	2	0	0	4	0	0	11		165.0		0	0.0	0.0	0.0	0.0					
								SF	SF	EA	EA	EA	EA	EA	EA	EA		FT		EA	LB	LB	LB	LB					
VERMONT AGENCY OF TRANSPORTATION							TOWN DIRECTIONAL TOTALS	489.4	0.0	46	4	4	100	0	0	86		1250.0		0	0.0								

PROJECT NAME: **STATEWIDE-SOUTH REGION**
PROJECT NUMBER: **STPG SIGN(57)**
FILE NAME: **z16t041Wallingford140EB.xls** PLOT DATE: **2/27/2017**
PROJECT MANAGER: **D. MUNRO** DRAWN BY: **W. GORDON**
DESIGNED BY: **P. MCKECHNIE** CHECKED **BRZEZOWSK**
WALLINGFORD VT-140 EB 13 SHEET **209** OF **264**