DIRECTION	MILEPOINT	LOCATION CODE (SHEET 4)	SIGN CODE	WIDTH (IN)	HEIGHT (IN)	SHEETING REMARKS	SIGN LEGEND	NEW SIGNS "A"	NEW SIGNS "B"	EXISTING SIGNS RETAIN	EXISTING SIGNS SALVAGE FROM	EXISTING SIGNS SALVAGE TO	EXISTING SIGNS REMOVE	EXIST POST RETAIN	EXIST POST REMOVE	NUMBER OF NEW POSTS	SQUARE STEEL (IN) 1.75 (LB / FT) 1.88	SQUARE STEEL (IN) 2.00 (LB / FT) 2.42	SQUARE STEEL (IN) 2.50 (LB / FT) 3.35	TUBULAR STEEL Ø (IN) FOUNDATION	TUBULAR STEEL Ø (IN) 3.00 (LB / FT) 7.60	TUBULAR STEEL Ø (IN) 3.50 (LB / FT) 9.00	TUBULAR STEEL Ø (IN) 4.00 (LB / FT) 10.80	TUBULAR STEEL Ø (IN) 5.00 (LB / FT) 14.60	SIGN FRAME REQUIRED	REMARKS	SIGN DETAIL LOCATION SHSM	SIGN DETAIL LOCATION SIGN DETAILS SHEET #	SIGN DETAIL LOCATION STANDARD SHEET #
WB WALLINGFORD VT RTE 140							FY-FLUORESCENT YELLOW FYG-FLUORESCENT YELLOW GREEN																			"SHSM"-STANDARD HIGHWAY SIGNS AND MARKINGS BOOK			
WB	3.860	F	W1-1R	30	30	FY	11/6/17	6.25								1		14'-9" X								INSTALL ±50' DOWNSTATION FROM EXISTING CURVE WARNING SIGN AT MP 3.870 WB	X		
		F	W13-1P	18	18	FY		2.25																		THINNING AND TRIMMING	X		
WB	3.665	F	W11-2										1		X														
		F	VW-258P				11/4/17						1																	
		F	W11-2	30	30	FYG		6.25								1		12'-0" X									X		
		F	VW-258P	24	18	FYG		3.00																				5	
WB	3.590	E	W1-6	48	24	FY	11/7/17	8.00								2		12'-3" 11'-3" X								INSTALL SIGN ±400' DOWNSTATION FROM EXISTING SIGN AT MP 3.665 WB	X		
WB	3.570	F	W1-6	48	24	FY	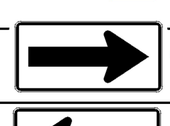 11/6/17	8.00								2		12'-3" 11'-9" X								INSTALL SIGN ±500' DOWNSTATION FROM EXISTING SIGN AT MP 3.665 WB	X		
WB	3.512	F	VD-701	6	10		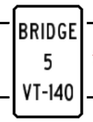 11/4/17	0.42								1	4'-9" X											T-42
WB	3.511	F	OM3-R				RIGHT OBJECT MARKER						1		X														
		F	VD-701				BRIDGE 5 PLAQUE						1																	
		F	OM3-R	12	36	FY	11/27/17	3.00								1		9'-9" X									X		
WB	3.508	E	OM3-L										1		X														
		E	OM3-L	12	36	FY	4/9/18	3.00								1		X									X		
SIGN SUMMARY SHEET							SHEET TOTALS	24.17	0.00	0	0	0	5	0	0	9		130.0		0	0.0	0.0	0.0	0.0					
								SF	SF	EA	EA	EA	EA	EA	EA	EA		FT		EA	LB	LB	LB	LB					
VERMONT AGENCY OF TRANSPORTATION							TOWN DIRECTIONAL TOTALS	572.0	0.0	35	2	2	128	0	0	93		1325.0		2		183.0							

PROJECT NAME: **STATEWIDE-SOUTH REGION**
PROJECT NUMBER: **STPG SIGN(57)**
FILE NAME: **z16t041Wallingford140WB.xls** PLOT DATE: **2/27/2017**
PROJECT MANAGER: **D. MUNRO** DRAWN BY: **W. GORDON**
DESIGNED BY: **P. MCKECHNIE** CHECKED **BRZEZOWSK**
WALLINGFORD VT-140 WB 8 SHEET **222** OF **264**