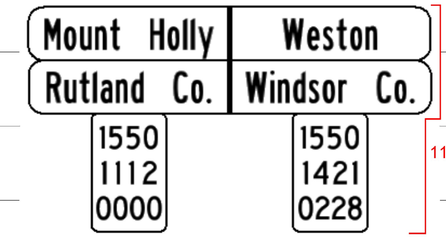
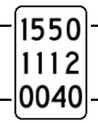
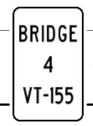
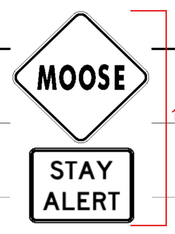
DIRECTION	MILEPOINT	LOCATION CODE (SHEET 4)	SIGN CODE	WIDTH (IN)	HEIGHT (IN)	SHEETING REMARKS	SIGN LEGEND	NEW SIGNS "A"	NEW SIGNS "B"	EXISTING SIGNS RETAIN	EXISTING SIGNS SALVAGE FROM	EXISTING SIGNS SALVAGE TO	EXISTING SIGNS REMOVE	EXIST POST RETAIN	EXIST POST REMOVE	NUMBER OF NEW POSTS	SQUARE STEEL (IN) 1.75 (LB / FT) 1.88	SQUARE STEEL (IN) 2.00 (LB / FT) 2.42	SQUARE STEEL (IN) 2.50 (LB / FT) 3.35	TUBULAR STEEL Ø (IN) FOUNDATION	TUBULAR STEEL Ø (IN) 3.00 (LB / FT) 7.60	TUBULAR STEEL Ø (IN) 3.50 (LB / FT) 9.00	TUBULAR STEEL Ø (IN) 4.00 (LB / FT) 10.80	TUBULAR STEEL Ø (IN) 5.00 (LB / FT) 14.60	SIGN FRAME REQUIRED	REMARKS	SIGN DETAIL LOCATION SHSM	SIGN DETAIL LOCATION SIGN DETAILS SHEET #	SIGN DETAIL LOCATION STANDARD SHEET #
NB MT HOLLY VT 155							FY-FLUORESCENT YELLOW FYG-FLUORESCENT YELLOW GREEN																			"SHSM"-STANDARD HIGHWAY SIGNS AND MARKINGS BOOK			
NB	0.000	C	VD-024	72	12			6.00								2		14'-0" 13'-6" X								INSTALL THIS ASSEMBLY AT SAME STATION ACROSS FROM EXISTING SB ASSEMBLY			T-94
		C	VD-024	72	12			6.00																					T-94
		C	VD-700	6	10			0.42																			INSTALL MOUNT HOLLY MILE MARKER ON THE LEFT POST UNDER MOUNT HOLLY			T-44
		C	VD-700	6	10			0.42																			INSTALL WESTON MILE MARKER ON THE RIGHT POST UNDER WESTON			T-44
NB	0.245	A	W1-2L	30	30	FY		6.25								1		16'-6" X								INSTALL 1295' UPSTATION FROM TOWN LINE SIGN ASSEMBLY	X		
		A	W13-1P	18	18	FY		2.25																				X		
NB	0.400	A	VD-700	6	10			0.42								1	7'-6" X									INSTALL 215' DOWNSTATION FROM EXISTING SIGN AT MP 0.441			
NB	0.441	A	VD-701				BRIDGE 4 VT 155						1		X														
		A	VD-700				MILE MARKER 1150 / 1112 / 0040						1																	
		A	VD-701	6	10			0.42								1	7'-9" X												T-42
NB	0.455	A	VW-000				MOOSE CROSSING						1		1														
		A	W7-3aP				NEXT 1 MILE						1																
NB	0.520	A	VW-001	30	30			6.25								1		16'-0" X								INSTALL SIGN 345' UPSTATION FROM EXISTING SIGN AT MP 0.455 NB			T-80
		A		24	18			3.00																				4	
							SHEET TOTALS	31.42	0.00	0	0	0	4	0	1	6		80.0		0	0.0	0.0	0.0	0.0				
								SF	SF	EA	EA	EA	EA	EA	EA	EA		FT		EA	LB	LB	LB	LB				
							TOWN DIRECTIONAL TOTALS	235.3	0.0	10	4	4	56	0	1	50		675.0		0	0.0							

SIGN SUMMARY SHEET

VERMONT AGENCY OF TRANSPORTATION

PROJECT NAME: STATEWIDE-SOUTH REGION
PROJECT NUMBER: STPG SIGN(57)

FILE NAME: z16t041Mt HollvVT155 NB.xls
PROJECT MANAGER: D. MUNRO
DESIGNED BY: P. MCKECHNIE
MOUNT HOLLY VT-155 NB 1

PLOT DATE: 2/27/2017
DRAWN BY: W. GORDON
CHECKED BRZEZOWSK