DIRECTION	MILEPOINT	LOCATION CODE (SHEET 4)	SIGN CODE	WIDTH (IN)	HEIGHT (IN)	SHEETING REMARKS	SIGN LEGEND	NEW SIGNS "A"	NEW SIGNS "B"	EXISTING SIGNS RETAIN	EXISTING SIGNS SALVAGE FROM	EXISTING SIGNS SALVAGE TO	EXISTING SIGNS REMOVE	EXIST POST RETAIN	EXIST POST REMOVE	NUMBER OF NEW POSTS	SQUARE STEEL (IN) 1.75 (LB / FT) 1.88	SQUARE STEEL (IN) 2.00 (LB / FT) 2.42	SQUARE STEEL (IN) 2.50 (LB / FT) 3.35	TUBULAR STEEL Ø (IN) FOUNDATION	TUBULAR STEEL Ø (IN) 3.00 (LB / FT) 7.60	TUBULAR STEEL Ø (IN) 3.50 (LB / FT) 9.00	TUBULAR STEEL Ø (IN) 4.00 (LB / FT) 10.80	TUBULAR STEEL Ø (IN) 5.00 (LB / FT) 14.60	SIGN FRAME REQUIRED	REMARKS	SIGN DETAIL LOCATION SHSM	SIGN DETAIL LOCATION SIGN DETAILS SHEET #	SIGN DETAIL LOCATION STANDARD SHEET #
NB MT HOLLY VT 155							FY-FLUORESCENT YELLOW FYG-FLUORESCENT YELLOW GREEN																			"SHSM"-STANDARD HIGHWAY SIGNS AND MARKINGS BOOK			
NB	3.715	A	VD-701				11/7/17						1		X														
		A	VD-701	6	10			0.42								1	9'-0" X												T-42
NB	4.115	A					REVERSE CURVE W/ INTERSECTION						1		X														
		A	W13-1P				40 MPH PLAQUE						1																
		A		36	36		11/13/17	9.00								2		14'-0" 13'-6" X								2	
		A	W13-1P	24	24			4.00																			INSTALL ON LEFT OF POST	X		
NB	4.171	A	S3-1	36	36	FYG	11/7/17	9.00																				X		
NB	4.205	A	VD1-1A										1		X														
		A	VD-700										1																
		A	S3-1				SCHOOL BUS STOP AHEAD						1															
		A	VD1-1A	72	12		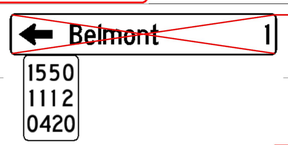 11/17/17	6.00								2		15'-3" 13'-0" X									T-93
		A	VD-700	6	10			0.42																			INSTALL ON LEFT POST			T-44
NB	4.257	C	VR-017				11/2/17						1		x													TARBELLVILLE RD (TH-1)			
		C	VR-017	24	30			5.00								1	14'-0" X												T-70
SIGN SUMMARY SHEET							SHEET TOTALS	33.83	0.00	0	0	0	7	0	0	6		85.0		0	0.0	0.0	0.0	0.0				
								SF	SF	EA	EA	EA	EA	EA	EA	EA		FT		EA	LB	LB	LB	LB				
VERMONT AGENCY OF TRANSPORTATION							TOWN DIRECTIONAL TOTALS	235.3	0.0	10	4	4	56	0	1	50		675.0		0	0.0							

PROJECT NAME: **STATEWIDE-SOUTH REGION**
PROJECT NUMBER: **STPG SIGN(57)**
FILE NAME: **z16t041Mt HollvVT155 NB.xls** PLOT DATE: **2/27/2017**
PROJECT MANAGER: **D. MUNRO** DRAWN BY: **W. GORDON**
DESIGNED BY: **P. MCKECHNIE** CHECKED **BRZEZOWSK**
MOUNT HOLLY VT-155 NB 5 SHEET **246** OF **264**