| DIRECTION | MILEPOINT | LOCATION CODE (SHEET 4) | SIGN CODE | WIDTH (IN) | HEIGHT (IN) | SHEETING REMARKS | SIGN LEGEND | NEW SIGNS "A" | NEW SIGNS "B" | EXISTING SIGNS RETAIN | EXISTING SIGNS SALVAGE FROM | EXISTING SIGNS SALVAGE TO | EXISTING SIGNS REMOVE | EXIST POST RETAIN | EXIST POST REMOVE | NUMBER OF NEW POSTS | SQUARE STEEL (IN) 1.75 (LB / FT) 1.88 | SQUARE STEEL (IN) 2.00 (LB / FT) 2.42 | SQUARE STEEL (IN) 2.50 (LB / FT) 3.35 | FOUNDATION | TUBULAR STEEL Ø (IN) 3.00 (LB / FT) 7.60 | TUBULAR STEEL Ø (IN) 3.50 (LB / FT) 9.00 | TUBULAR STEEL Ø (IN) 4.00 (LB / FT) 10.80 | TUBULAR STEEL Ø (IN) 5.00 (LB / FT) 14.60 | SIGN FRAME REQUIRED | REMARKS | SIGN DETAIL LOCATION SHSM | SIGN DETAIL LOCATION SIGN DETAILS SHEET # | SIGN DETAIL LOCATION STANDARD SHEET # |
|---|---|---|---|---|---|---|---|---|---|---|---|---|---|---|---|---|---|---|---|---|---|---|---|---|---|---|---|---|---|
| **SB MT HOLLY VT 155** | | | | | | | FY-FLUORESCENT YELLOW<br>FYG-FLUORESCENT YELLOW GREEN | | | | | | | | | | | | | | | | | | | | "SHSM"-STANDARD HIGHWAY SIGNS AND MARKINGS BOOK | | | |
| SB | 7.415 | F | R2-1 | | | | 11/13/17 SPEED LIMIT 50 MPH | | | | | 1 | | | | 1 | | 12'-6" X | | | | | | | | INSTALL ACROSS FROM SB-FACING SPEED LIMIT 35 SIGN | | | |
| SB | 7.395 | F | R2-1 | | | | SPEED LIMIT 50 MPH | | | | 1 | | 1 | | X | | | | | | | | | | | | | | |
| SB | 7.390 | F | W1-2L | 30 | 30 | | 11/28/17 | 6.25 | | | | | | | | 1 | | 13'-6" X | | | | | | | | INSTALL 25' DOWNSTATION FROM EXISTING SIGN AT MP 7.395 | X | | |
| SB | 7.120 | F | VD-701 | | | | 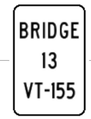 11/13/17 | | | | | | 1 | | X | | | | | | | | | | | | | | | |
| | | F | VD-701 | 6 | 10 | | | 0.42 | | | | | | | | 1 | | 8'-9" X | | | | | | | | | | | T-42 |
| SB | 6.905 | F | | | | | BUMP | | | 1 | | | | X | | | | | | | | | | | | | SEASONAL SIGN | | | |
| SB | 6.895 | F | VD-701 | | | | 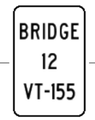 11/13/17 | | | | | | 1 | | X | | | | | | | | | | | | | | | |
| | | F | VD-701 | 6 | 10 | | | 0.42 | | | | | | | | 1 | | 7'-3" X | | | | | | | | | | | T-42 |
| SB | 6.890 | FE | D3-1 | | | | TH8 Fowler Brook Rd | | | 1 | | | | X | | | | | | | | | | | | | FOWLER BROOK RD (TH-8) | | | |
| SB | 6.885 | G | VR-017 | | | | 11/3/17 | | | | | | 1 | X | | | | | | | | | | | | | THINNING AND TRIMMING | | | |
| | | G | VR-017 | 24 | 30 | | | 5.00 | | | | | | | | | | | | | | | | | | | INSTALL ON RETAINED POST | | | T-70 |
| SB | 6.880 | H | R1-1 | | | | | | | | | | 1 | | X | | | | | | | | | | | | | | | |
| | | G | VD-700 | | | | MILE MARKER 1550/1112/0689 | | | | 1 | | 1 | | | | | | | | | | | | | | | | | |
| | | H | R1-1 | 30 | 30 | | 11/3/17 | 6.25 | | | | | | | | 1 | | 11'-3" X | | | | | | | | | | X | |
| | | G | VD-700 | | | | MILE MARKER 1550/1112/0689 | | | | | 1 | | | | | | | | | | | | | | | INSTALL BACK TO BACK ON STOP SIGN POST | | | |
| **SIGN SUMMARY SHEET** | | | | | | | SHEET TOTALS | 18.33 SF | 0.00 SF | 2 EA | 2 EA | 2 EA | 6 EA | 0 EA | 0 EA | 5 EA | | 65.0 FT | | 0 EA | 0.0 LB | 0.0 LB | 0.0 LB | 0.0 LB | | | | | |
| VERMONT AGENCY OF TRANSPORTATION | | | | | | | TOWN DIRECTIONAL TOTALS | 171.1 | 0.0 | 7 | 3 | 3 | 39 | 0 | 0 | 32 | | 465.0 | | 0 | 0.0 | | | | | | | | |

PROJECT NAME: **STATEWIDE-SOUTH REGION**
PROJECT NUMBER: **STPG SIGN(57)**
FILE NAME: **z16t041Mt HollvVT155 SB.xls** PLOT DATE: **2/27/2017**
PROJECT MANAGER: **D. MUNRO** DRAWN BY: **W. GORDON**
DESIGNED BY: **P. MCKECHNIE** CHECKED **BRZEZOWSK**
MOUNT HOLLY VT-155 SB 1 SHEET **251** OF **264**