DIR	MILEPOINT	LOCATION CODE	MUTCD CODE	WIDTH	HEIGHT	SHEETING REMARKS	SIGN LEGEND	NEW SIGNS "A"	NEW SIGNS "B"	EXISTING SIGNS RETAIN	EXISTING SIGNS SALVAGE FROM	EXISTING SIGNS SALVAGE TO	EXISTING SIGNS REMOVE	EXIST POST RETAIN	EXIST POST REMOVE	NUMBER OF NEW POSTS	SQUARE STEEL (in) 1.75 (LB / FT) 1.88	SQUARE STEEL (in) 2.00 (LB / FT) 2.42	SQUARE STEEL (in) 2.50 (LB / FT) 3.35	FOUNDATION	TUBULAR STEEL Ø (IN) 3.00 (LB / FT) 7.60	TUBULAR STEEL Ø (IN) 3.50 (LB / FT) 9.00	TUBULAR STEEL Ø (IN) 4.00 (LB / FT) 10.80	TUBULAR STEEL Ø (IN) 5.00 (LB / FT) 14.60	SIGN FRAME REQUIRED	REMARKS	SIGN DETAIL: DETAIL IN SHSM	SIGN DETAIL: DETAIL ON SHEET NUMBER	SIGN DETAIL: DETAIL ON STD SHEET NUMBER
ST ALBANS TOWN			**VT36**	**EB**			FYG-FLUORESCENT YELLOW-GREEN																			"SHSM" - STANDARD HIGHWAY SIGNS AND MARKINGS			
		A	R2-1	30	36			7.50																			X		
							ST. ALBANS CITY LIMITS																						
EB	2.853	A	W11-2	30	30	FYG	PEDESTRIAN						1		1														
		A	W16-7P	24	12	FYG	45 DEG ARROW						1																
		A	W11-2	30	30	FYG		6.25								1			14.75 X							X		
		A	W16-7P	24	12	FYG		2.00																		X		
EB	2.865	A	M2-1	21	15		JCT			1				1															
		A	VM1-5	30	24		VT 104			1																			
EB	2.875	A	VD1-1A	72	12		^UP ARROW FAIRFIELD 7						1		2														
		A	VD1-1A	72	12		^UP ARROW BAKERSFIELD 14						1																
		A	VD1-1A	72	12		FAIRFAX 11 ---> (90 DEG) RIGHT						1																
		A	VD1-1A	72	12			6.00								2			10.75 X 10.50							REQUIRES SLIP BASES			T-93
		A	VD1-1A	72	12			6.00																					T-93
		A	VD1-1A	72	12			6.00																					T-93
		A	VD1-1A	72	12		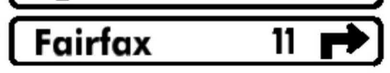	6.00																					T-93
							SHEET TOTALS	39.75	0.00	2	0	0	5	1	3	3		~~45~~		0	0								
								SF	SF	EA	EA	EA	EA	EA	EA	EA		FT											
																		36											
							TOWN TOTALS	326.25	0.00	76	7	7	62	52	29	45		675		1	210								

SIGN SUMMARY SHEET

VERMONT AGENCY OF TRANSPORTATION

PROJECT NAME: **STATEWIDE- NORTHWEST**
PROJECT NUMBER: **STPG SIGN (58)**

FILE NAME: **z16T042 VT36-ST ALBANS EB.** PLOT DATE: **3/10/2017**
PROJECT MANAGER: **B. BRESLEND** DRAWN BY: **O. DALMER**
DESIGNED BY: **O. DALMER** CHECKED BY: **B. BRESLEND**
ST ALBANS TOWN VT36 EB 9 SHEET **22** OF **146**