DIR	MILEPOINT	LOCATION CODE	MUTCD CODE	WIDTH	HEIGHT	SHEETING REMARKS	SIGN LEGEND	NEW SIGNS "A"	NEW SIGNS "B"	EXISTING SIGNS RETAIN	EXISTING SIGNS SALVAGE FROM	EXISTING SIGNS SALVAGE TO	EXISTING SIGNS REMOVE	EXIST POST RETAIN	EXIST POST REMOVE	NUMBER OF NEW POSTS	SQUARE STEEL (in) 1.75 (LB / FT) 1.88	SQUARE STEEL (in) 2.00 (LB / FT) 2.42	SQUARE STEEL (in) 2.50 (LB / FT) 3.35	FOUNDATION	TUBULAR STEEL Ø (IN) 3.00 (LB / FT) 7.60	TUBULAR STEEL Ø (IN) 3.50 (LB / FT) 9.00	TUBULAR STEEL Ø (IN) 4.00 (LB / FT) 10.80	TUBULAR STEEL Ø (IN) 5.00 (LB / FT) 14.60	SIGN FRAME REQUIRED	REMARKS	SIGN DETAIL: DETAIL IN SHSM	SIGN DETAIL: DETAIL ON SHEET NUMBER	SIGN DETAIL: DETAIL ON STD SHEET NUMBER
ST ALBANS TOWN			**VT36**	**EB**			FYG-FLUORESCENT YELLOW-GREEN																			"SHSM" - STANDARD HIGHWAY SIGNS AND MARKINGS			
		B	W1-8R	18	24		CHEVRON						1													BACK TO BACK			
	4.805	A	W1-8L	18	24			3.00																			X		
EB	4.806	B	W1-8R	18	24			3.00								1		13.25 X								INSTALL SIGN 5 FEET FROM COMPLEMENTARY CHEVRON SIGN	X		
EB	4.815	C	VR-017	24	30		LLL 24,000 LBS			1				1												TH 46			
EB	4.825	D	R1-1	30	30		STOP			1				1												TH 46			
		C	VD-700	6	10		MM 0036,0613, 0484			1																TH 46			
EB	4.827	A	VD3-1	18	6		RUGG RD				TWO OLD SIGNS REMOVED		2 ~~1~~		~~1~~			PLACED ON TOP OF STOP								TH 46			
		A	VD3-1	42	12		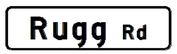	3.50								~~1~~		~~X~~								TH 46	5		
EB	4.989	A	VW-133L	30	30		HIDDEN DRIVE LEFT						1		1														
EB	5.035	A	VW-133L	30	30			6.25								1		16.50 X								INSTALL SIGN 240 FEET EAST OF EXISTING LOCATION			T-81

SIGN SUMMARY SHEET

VERMONT AGENCY OF TRANSPORTATION

	NEW SIGNS "A"	NEW SIGNS "B"	EXISTING SIGNS RETAIN	EXISTING SIGNS SALVAGE FROM	EXISTING SIGNS SALVAGE TO	EXISTING SIGNS REMOVE	EXIST POST RETAIN	EXIST POST REMOVE	NUMBER OF NEW POSTS	SQUARE STEEL (in)	FOUNDATION	SIGN FRAME REQUIRED
SHEET TOTALS	15.75	0.00	3	0	0	~~3~~	2	~~2~~	~~3~~	~~45~~	0	0
	SF	SF	EA	EA	EA	EA	EA	EA	EA	FT		
						4		1	2	29.75		
TOWN TOTALS	326.25	0.00	76	7	7	62	52	29	45	675	1	210

PROJECT NAME: **STATEWIDE- NORTHWEST**
PROJECT NUMBER: **STPG SIGN (58)**
FILE NAME: **z16T042 VT36-ST ALBANS EB.** PLOT DATE: **3/10/2017**
PROJECT MANAGER: **B. BRESLEND** DRAWN BY: **O. DALMER**
DESIGNED BY: **O. DALMER** CHECKED BY: **B. BRESLEND**
ST ALBANS TOWN VT36 EB 14 SHEET **27** OF **146**