DIR	MILEPOINT	LOCATION CODE	MUTCD CODE	WIDTH	HEIGHT	SHEETING REMARKS	SIGN LEGEND	NEW SIGNS "A"	NEW SIGNS "B"	EXISTING SIGNS RETAIN	EXISTING SIGNS SALVAGE FROM	EXISTING SIGNS SALVAGE TO	EXISTING SIGNS REMOVE	EXIST POST RETAIN	EXIST POST REMOVE	NUMBER OF NEW POSTS	SQUARE STEEL (in) 1.75 (LB / FT) 1.88	SQUARE STEEL (in) 2.00 (LB / FT) 2.42	SQUARE STEEL (in) 2.50 (LB / FT) 3.35	FOUNDATION	TUBULAR STEEL Ø (IN) 3.00 (LB / FT) 7.60	TUBULAR STEEL Ø (IN) 3.50 (LB / FT) 9.00	TUBULAR STEEL Ø (IN) 4.00 (LB / FT) 10.80	TUBULAR STEEL Ø (IN) 5.00 (LB / FT) 14.60	SIGN FRAME REQUIRED	REMARKS	SIGN DETAIL: DETAIL IN SHSM	SIGN DETAIL: DETAIL ON SHEET NUMBER	SIGN DETAIL: DETAIL ON STD SHEET NUMBER
FAIRFIELD			**VT36**	**EB**			FYG-FLUORESCENT YELLOW-GREEN																			"SHSM" - STANDARD HIGHWAY SIGNS AND MARKINGS			
EB	2.943	A	VW-133R	30	30		HIDDEN DRIVE RIGHT				1	1	1		1			14.50 X										
EB	3.158 3.450	A	VW-133L	30	30		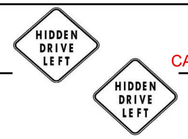 CATTLE CROSSING	6.25 6.25								1		13.50 X 14.50								INSTALL SIGN 75 FEET EAST OF WESTERN GUARDRAIL SECTION			T-81
EB	3.703	A	VW-133L	30	30			6.25								1		13.75 X								INSTALL SIGN 105 FEET WEST OF UTILITY POLE			T-81
EB	4.028	A	W3-5	36	36		SPEED REDUCTION SL 35						1	2														
		A	W3-5	36	36			9.00																			X	
EB	4.073	A	VD-062B	72	16		PRES. ARTHUR <===			1				2												HISTORIC SITE 6			
		A	VD-062B	72	16		ST. PATRICK CHURCH <===			1																CHURCH ROAD 1/2			
EB	4.113	A	VD-018A	30	18		FAIRFIELD						1		1											E FAIRFIELD 5			
		A	VD-018A	36	24			6.00								2		12.00 X 12.00											T-95
EB	4.173	A	R2-1	24	30		SPEED LIMIT 35					1	1		1			13.50 X								PUNCH LIST - RETURN SIGN TO ORIGINAL LOCATION			
EB	4.193	A	R2-1	30	36			7.50			1		1		1	1		13.25 X								INSTALL SIGN 105 FEET EAST OF *EXISTING LOCATION*	X		
EB	4.218	A	S1-1	36	36		SCHOOL						1	2														
		A	W16-9P	36	10		AHEAD						1															
		A	S1-1	36	36	FYG		9.00																			X	
		A	S4-3P	24	8	FYG		1.33																			X	
							SHEET TOTALS	~~45.33~~	0.00	2	0	~~0~~	~~6~~	6	3	5		~~75~~										
								SF	SF	EA	EA	EA	EA	EA	EA	EA		FT										
								51.58				2	7					107										
							TOWN TOTALS	461.50	0.00	25	16	16	87	32	60	92		1380										

SIGN SUMMARY SHEET

VERMONT AGENCY OF TRANSPORTATION

PROJECT NAME: STATEWIDE- NORTHWEST
PROJECT NUMBER: STPG SIGN (58)

FILE NAME: z16T042 VT36-FAIRFIELD EB.x
PROJECT MANAGER: B. BRESLEND
DESIGNED BY: O. DALMER
FAIRFIELD VT36 EB 3

PLOT DATE: 3/10/2017
DRAWN BY: O. DALMER
CHECKED BY: B. BRESLEND
SHEET 44 OF 146