DIR	MILEPOINT	LOCATION CODE	MUTCD CODE	WIDTH	HEIGHT	SHEETING REMARKS	SIGN LEGEND	NEW SIGNS "A"	NEW SIGNS "B"	EXISTING SIGNS RETAIN	EXISTING SIGNS SALVAGE FROM	EXISTING SIGNS SALVAGE TO	EXISTING SIGNS REMOVE	EXIST POST RETAIN	EXIST POST REMOVE	NUMBER OF NEW POSTS	SQUARE STEEL (in) 1.75 (LB / FT) 1.88	SQUARE STEEL (in) 2.00 (LB / FT) 2.42	SQUARE STEEL (in) 2.50 (LB / FT) 3.35	FOUNDATION	TUBULAR STEEL Ø (IN) 3.00 (LB / FT) 7.60	TUBULAR STEEL Ø (IN) 3.50 (LB / FT) 9.00	TUBULAR STEEL Ø (IN) 4.00 (LB / FT) 10.80	TUBULAR STEEL Ø (IN) 5.00 (LB / FT) 14.60	SIGN FRAME REQUIRED	REMARKS	SIGN DETAIL: DETAIL IN SHSM	SIGN DETAIL: DETAIL ON SHEET NUMBER	SIGN DETAIL: DETAIL ON STD SHEET NUMBER
FAIRFIELD			**VT36**	**WB**			FYG-FLUORESCENT YELLOW-GREEN																			"SHSM" - STANDARD HIGHWAY SIGNS AND MARKINGS			
WB	6.213	F	VD3-1	36	6		STONEHOUSE RD TH80						1		1											TH 80			
		F	R1-1	30	30		STOP						1													TH 80			
		G	VD-700	6	10		MM 0360, 0605, 0623				1	1	1													TH 80. SALVAGE SIGN ON NEW POST IN EXISTING LOCATION			
		F	R1-1	30	30			6.25								1		13.50 X							TH 80	X		
WB	6.213 5.730	F	VD3-1	72	12			6.00					1			2 1		11.00 X 10.75								TH 80. INSTALL SIGN 10 FEET MINIMUM FROM STOP SIGN		7	
WB	5.098	F	VR2-5A	24	30		REDUCED SPEED AHEAD						1	2												REMOVE DAMAGED POST (5.730)			
		F	W3-5	36	36			9.00																			X		
WB	5.048	F	W11-8	30	30		FIRETRUCK						1		1														
		F	W11-8	30	30			6.25								1		13.50 X								X		
WB	5.008	F	VD-018A	36	24		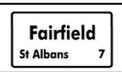	6.00								2		12.50 X 14.00							INSTALL SIGN 25 FEET EAST OF DRIVEWAY			T-95
WB	4.973	F	R2-1	24	30		SPEED LIMIT 35						1		1														
		F	R2-1	30	36			7.50								1		13.75 X								X		
WB	4.728	F	VD-062	72	16		PRESIDENT ARTHUR ===>			1				2											HISTORIC SITE 6			
WB	4.653	F	R2-1	24	30		SPEED LIMIT 35			1				1														
WB	4.603	F	W3-1	30	30		STOP AHEAD			1				2														
							SHEET TOTALS	41.00 SF	0.00 SF	3 EA	1 EA	1 EA	7 ~~6~~ EA	7 EA	3 EA	7 EA		~~105~~ FT										
							TOWN TOTALS	351.58	0.00	16	7	5	55	24	35	64		89.00 960										

SIGN SUMMARY SHEET

VERMONT AGENCY OF TRANSPORTATION

PROJECT NAME: **STATEWIDE- NORTHWEST**
PROJECT NUMBER: **STPG SIGN (58)**

FILE NAME: **z16T042 VT36-FAIRFIELD WB.dgn** PLOT DATE: **3/10/2017**
PROJECT MANAGER: **B. BRESLEND** DRAWN BY: **O. DALMER**
DESIGNED BY: **O. DALMER** CHECKED BY: **B. BRESLEND**
FAIRFIELD VT36 WB 6 SHEET **61** OF **146**