DIR	MILEPOINT	LOCATION CODE	MUTCD CODE	WIDTH	HEIGHT	SHEETING REMARKS	SIGN LEGEND	NEW SIGNS "A"	NEW SIGNS "B"	EXISTING SIGNS RETAIN	EXISTING SIGNS SALVAGE FROM	EXISTING SIGNS SALVAGE TO	EXISTING SIGNS REMOVE	EXIST POST RETAIN	EXIST POST REMOVE	NUMBER OF NEW POSTS	SQUARE STEEL (in) 1.75 (LB / FT) 1.88	SQUARE STEEL (in) 2.00 (LB / FT) 2.42	SQUARE STEEL (in) 2.50 (LB / FT) 3.35	FOUNDATION	TUBULAR STEEL Ø (IN) 3.00 (LB / FT) 7.60	TUBULAR STEEL Ø (IN) 3.50 (LB / FT) 9.00	TUBULAR STEEL Ø (IN) 4.00 (LB / FT) 10.80	TUBULAR STEEL Ø (IN) 5.00 (LB / FT) 14.60	SIGN FRAME REQUIRED	REMARKS	SIGN DETAIL: DETAIL IN SHSM	SIGN DETAIL: DETAIL ON SHEET NUMBER	SIGN DETAIL: DETAIL ON STD SHEET NUMBER
CAMBRIDGE			**VT104**	**SB**			FYG-FLUORESCENT YELLOW-GREEN																			"SHSM" - STANDARD HIGHWAY SIGNS AND MARKINGS			
	0.345	H	R1-1	30	30			6.25								~~1~~		X			ON POST AT 0.350 WITH VT 104					TH 88	X		
SB	0.215	F	W11-4	30	30		CATTLE						1		1											SYMBOL			
		F	W11-4	30	30			6.25								1		14.00 X									X		
SB	0.170	F	M2-1	21	15		JCT						1		2														
		F	VM1-5	24	24		VT 15						1																
		F	M4-6	24	12		END						1																
		F	VM1-5	30	24		VT 104						1																
		F	M2-1	21	15			2.19								2		32.25 X							2B	GREEN ON WHITE	X		
		F	VM1-5	24	24		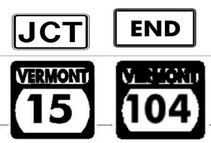	4.00																				E-136B	
		F	M4-6	24	12			2.00																		GREEN ON WHITE	X		
		F	VM1-5	30	24			5.00																				E-136B	
SB	0.130	F	W3-1	36	36		STOP AHEAD						1	2												SYMBOL FLASHING LIGHTS			
		F	W3-1	36	36			9.00 + 16.00					1													REPLACED BY 48 X 48	X		
SB	0.095	F	VD1-1A	72	10		^ UP CAMBRIDGE						1		2														
		F	VD1-1A	72	10		^ UP JEFFERSONVILLE 3						1																
							SHEET TOTALS	~~34.69~~ SF	0.00 SF	0 EA	0 EA	0 EA	~~8~~ EA	2 EA	5 EA	~~4~~ EA		60 FT											
								50.69					9			3		46.25										
							TOWN TOTALS	89.19	0.00	12	1	1	17	11	11	14		210										

SIGN SUMMARY SHEET

VERMONT AGENCY OF TRANSPORTATION

PROJECT NAME: **STATEWIDE- NORTHWEST**
PROJECT NUMBER: **STPG SIGN (58)**
FILE NAME: **z16T042 VT104-CAMBRIDGE S** PLOT DATE: **3/10/2017**
PROJECT MANAGER: **B. BRESLEND** DRAWN BY: **O. DALMER**
DESIGNED BY: **O. DALMER** CHECKED BY: **B. BRESLEND**
CAMBRIDGE VT104 SB 2 SHEET **75** OF **146**