DIR	MILEPOINT	LOCATION CODE	MUTCD CODE	WIDTH	HEIGHT	SHEETING REMARKS	SIGN LEGEND	NEW SIGNS "A"	NEW SIGNS "B"	EXISTING SIGNS RETAIN	EXISTING SIGNS SALVAGE FROM	EXISTING SIGNS SALVAGE TO	EXISTING SIGNS REMOVE	EXIST POST RETAIN	EXIST POST REMOVE	NUMBER OF NEW POSTS	SQUARE STEEL (in) 1.75 (LB / FT) 1.88	SQUARE STEEL (in) 2.00 (LB / FT) 2.42	SQUARE STEEL (in) 2.50 (LB / FT) 3.35	TUBULAR STEEL Ø (IN) FOUNDATION	TUBULAR STEEL Ø (IN) 3.00 (LB / FT) 7.60	TUBULAR STEEL Ø (IN) 3.50 (LB / FT) 9.00	TUBULAR STEEL Ø (IN) 4.00 (LB / FT) 10.80	TUBULAR STEEL Ø (IN) 5.00 (LB / FT) 14.60	SIGN FRAME REQUIRED	REMARKS	SIGN DETAIL: DETAIL IN SHSM	SIGN DETAIL: DETAIL ON SHEET NUMBER	SIGN DETAIL: DETAIL ON STD SHEET NUMBER
FAIRFAX			**VT104**	**NB**			FYG-FLUORESCENT YELLOW-GREEN																			"SHSM" - STANDARD HIGHWAY SIGNS AND MARKINGS			
NB	4.178	A	R2-1	24	30		SPEED LIMIT 40						1	1														
		A	R2-1	24	30			5.00																		X		
NB	4.268	A	W1-10bR	30	30		MODIFIED RIGHT CURVE			1				1														
NB	4.323	A	M2-1	21	15		JCT						1		1													
		A	VM1-5	30	24		VT 128						1															
		A	M2-1	21	15			2.19								1		14.50 X								GREEN ON WHITE	X		
		A	VM1-5	30	24			5.00																				E-136B
NB	4.343	A	VD1-1A	72	10		^UP WESTFORD 3						1		2													
		A	VD1-1A	72	10		^UP ESSEX 12						1															
		A	VD1-1A	72	10		FAIRFAX 1 (45 DEG) --->						1															
		A	VD1-1A	72	10		ST ALBANS 14 (45 DEG) --->						1															
		A	VD1-1A	72	12		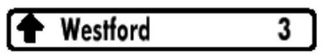	6.00								2			24.25 X						REQUIRES SLIP BASES			T-93
		A	VD1-1A	72	12		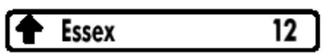	6.00																				T-93
		A	VD1-1A	72	12		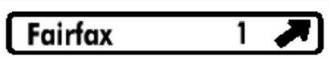	6.00																				T-93
		A	VD1-1A	72	12			6.00																				T-93
SIGN SUMMARY SHEET							SHEET TOTALS	36.19	0.00	1	0	0	7	2	3	3		~~45~~										
								SF	SF	EA	EA	EA	EA	EA	EA	EA		FT										
VERMONT AGENCY OF TRANSPORTATION																		38.75										
							TOWN TOTALS	500.47	0.00	53	12	14	117	67	60	69		1035										

PROJECT NAME: **STATEWIDE- NORTHWEST**
PROJECT NUMBER: **STPG SIGN (58)**

FILE NAME: **z16T042 VT104-FAIRFAX NB.xl** PLOT DATE: **3/10/2017**
PROJECT MANAGER: **B. BRESLEND** DRAWN BY: **O. DALMER**
DESIGNED BY: **O. DALMER** CHECKED BY: **B. BRESLEND**
FAIRFAX VT104 NB 5 SHEET **81** OF **146**