STATION	MUTCD CODE	WIDTH	HEIGHT	SHEETING REMARKS	SIGN LEGEND	NEW SIGNS "A"	NEW SIGNS "B"	EXISTING SIGNS RETAIN	EXISTING SIGNS SALVAGE FROM	EXISTING SIGNS SALVAGE TO	EXISTING SIGNS REMOVE	EXIST POST RETAIN	EXIST POST REMOVE	NUMBER OF NEW POSTS	SQUARE STEEL (in) 1.75 (LB / FT) 1.88	SQUARE STEEL (in) 2.00 (LB / FT) 2.42	SQUARE STEEL (in) 2.50 (LB / FT) 3.35	FOUNDATION	TUBULAR STEEL Ø (IN) 3.00 (LB / FT) 7.60	TUBULAR STEEL Ø (IN) 3.50 (LB / FT) 9.00	TUBULAR STEEL Ø (IN) 4.00 (LB / FT) 10.80	TUBULAR STEEL Ø (IN) 5.00 (LB / FT) 14.60	SIGN FRAME REQUIRED	REMARKS	SIGN DETAIL: DETAIL IN SHS	SIGN DETAIL: DETAIL ON SHEET NUMBER	SIGN DETAIL: DETAIL ON STD SHEET NUMBER
BERKSHIRE VT 105					FY- FLOURESCENT YELLOW FYG- FLOURESCENT YELLOW GREEN																						
B 50+51, LT	M3-1	24	12	BLK WHT		2.00								1		X									X		
	M1-5	30	24	BLK WHT		5.00																					E-136B
B 50+75, RT	W1-7	48	24		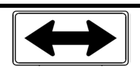	8.00								2		X								INSTALL FACING BERKSHIRE CENTER RD. (SNTH 118)	X		
B 54+50, LT	M3-2	24	12	GRN WHT		2.00								2		X							2C	INSTALL FACING EASTBOUND TRAFFIC	X		
	M1-5	30	24	GRN WHT		5.00																					E-136B
	M6-3	21	15	GRN WHT	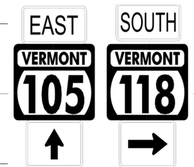	2.19																			X		
									1	1																	
									1	1																	
B 55+21, RT	M3-3	24	12	GRN WHT		2.00								1		X									X		
	M1-5	30	24	GRN WHT		5.00																					E-136B
B 55+66, RT	R1-1	30	30		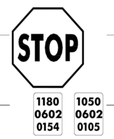	6.25								1		X									X		
	VD-700	6	10			0.42																					T-44
	VD-700	6	10			0.42																		MOUNT SIGNS BACK-TO-BACK WITH STOP SIGN			T-44
					SHEET TOTALS	38.28	0.00	0	3	3	0	0	0	7		105		0	0	0	0	0					
						SF	SF	EA	EA	EA	EA	EA	EA	EA		FT		EA	LB	LB	LB	LB					
					TOWN TOTALS	205.49	0.00	0	33	33	0	0	0	100		1311		2	204	0	0	0					

SIGN SUMMARY SHEET

VERMONT AGENCY OF TRANSPORTATION

PROJECT NAME: ENOSBURG-RICHFORD
PROJECT NUMBER: STP 2969(1)

FILE NAME: z16v104BerkshireTSSS.xls
PROJECT MANAGER: J. LITTLE
DESIGNED BY: G. BURGMEIER
TRAFFIC SIGN SUMMARY SHEET 10

PLOT DATE: 3/13/2018
DRAWN BY: G. BURGMEIER
CHECKED BY: J. LITTLE