WOOD GUARD RAIL REQUIRED.

LEFT

Sta 636+34 to 636+58 Length 24 ft.

RIGHT

Sta. 636+34 to 636+58 Length 24 ft.

NEW CULVERTS REQUIRED.

Sta. 636+46 - 30" Reinf. Concrete Pipe Culvert 32 Lin. ft.
Concrete Class A (1-2-4 3.9 ~~5.5~~ Cu. Yds.
Reinforcing Steel 54 ~~66~~ pounds.

FED. ROAD DIST. NO.	STATE	FED. AID PROJ. NO.	FISCAL YEAR	SHEET NO.	TOTAL SHEETS
9	VT.	728	1928	14	104

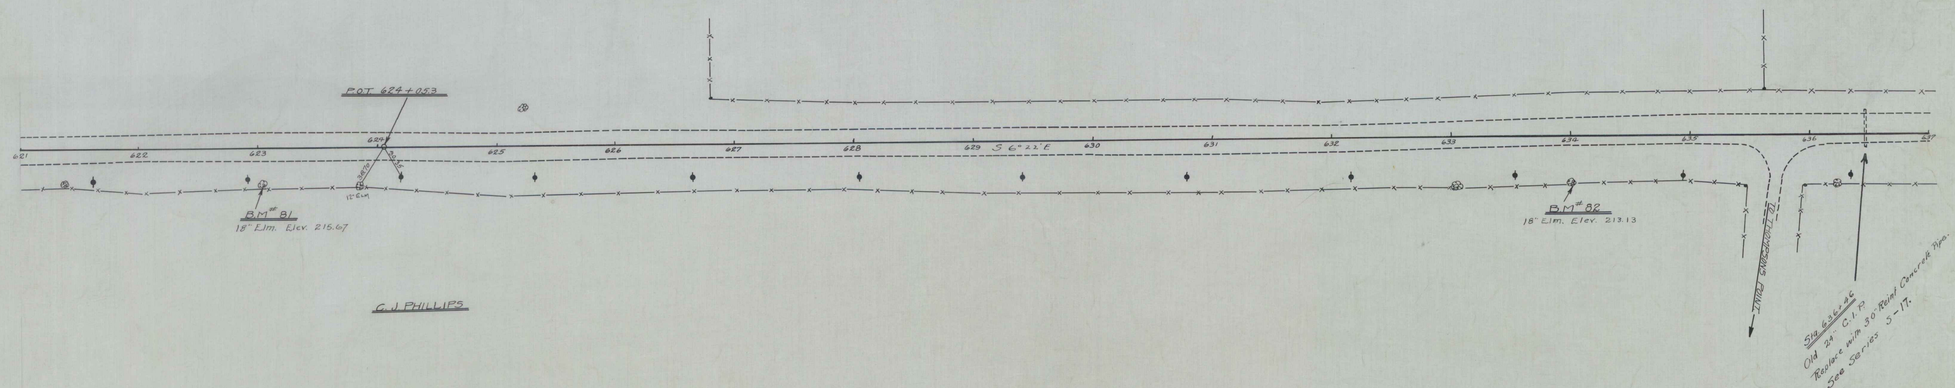

C. J. PHILLIPS

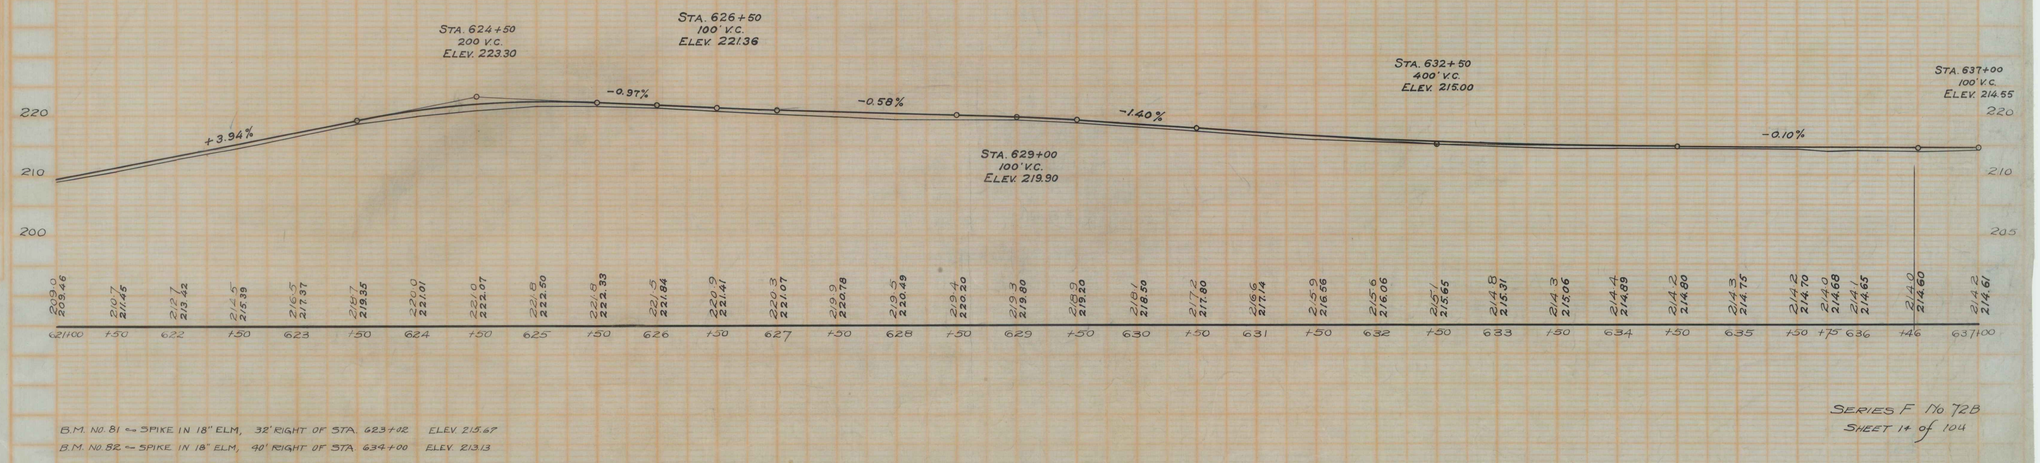

B.M. No. 81 — SPIKE IN 18" ELM, 32' RIGHT OF STA. 623+82 ELEV. 215.67
B.M. No. 82 — SPIKE IN 18" ELM, 40' RIGHT OF STA. 634+00 ELEV. 213.13

SERIES F No 728
SHEET 14 of 104