FED. ROAD DIST. NO.	STATE	FED. AID PROJ. NO.	FISCAL YEAR	SHEET NO.	TOTAL SHEETS
3	VT.	728	1938	29	104

WOOD GUARD RAIL REQUIRED.

		LEFT			
Sta.	865+17	to	865+~~57~~ 41	Length	~~40~~ 24 ft.
"	850+68	"	850+92	"	24 "
	857+29	"	857+53	"	24 "
		RIGHT			
Sta	865+17	to	865+57	Length	40 ft.
	850+68	"	850+92	"	24 "

CABLE GUARD RAIL REQUIRED.

LEFT

~~Sta. 850+40 to 850+96 Length 56 ft.~~

RIGHT

~~Sta. 830+40 to 831+04 Length 64 ft.~~

" ~~855+20~~ 854+56 " ~~30~~ 54 ft.

~~858+00~~ 858+00 " ~~45~~ 45 "

NEW CULVERTS REQUIRED.

Sta. 865+29 - 3'x3' Reinf. Concrete Box Culvert 36 ft.

Concrete Class A (1-2-4) 17.1 Cu.Yds. 13.6

Reinforcing Steel 1058 ~~1068~~ pounds.

NEW CULVERTS REQUIRED

Sta. 857+41 - 24~~18~~" Reinf. Concrete Pipe Culvert ~~36~~ 46 Lin.ft.

Concrete Class B (1-2½-3) 11.7 ~~24~~ Cu.Yds.

Reinforcing Steel 1.2 " " 4.4 ~~28~~ pounds.

CULVERT REPAIRS REQUIRED.

Sta. 850+80 Concrete Arch Box

Build New floor,

Concrete Class A (1-2-4) 3.6 ~~14~~ Cu.Yds.

Reinforcing Steel 190 ~~173~~ pounds.

DRIVEWAY CULVERT REPAIRS

Sta. ~~853+10 12" C.M.P.~~

~~Build New Headwalls~~

~~Concrete Class B (1-2½-3) 1.1 Cu.Yds.~~

SUB-BASE OF GRAVEL REQUIRED.

Sta. 854+00 to 861+00 - 6" Sub-base of gravel 700 Lin.ft.

" 861+00 to 866+00 - 9 " " " 500 " "

850+00 " 851+00 6" " " " 100 " "

Driveway Culvert Require

Sta 853+00 - left - 12" Corr. Galv. Metal Pipe - 20 Lin ft

Concrete Class B (1-2½-3) 1.4 cu yd.

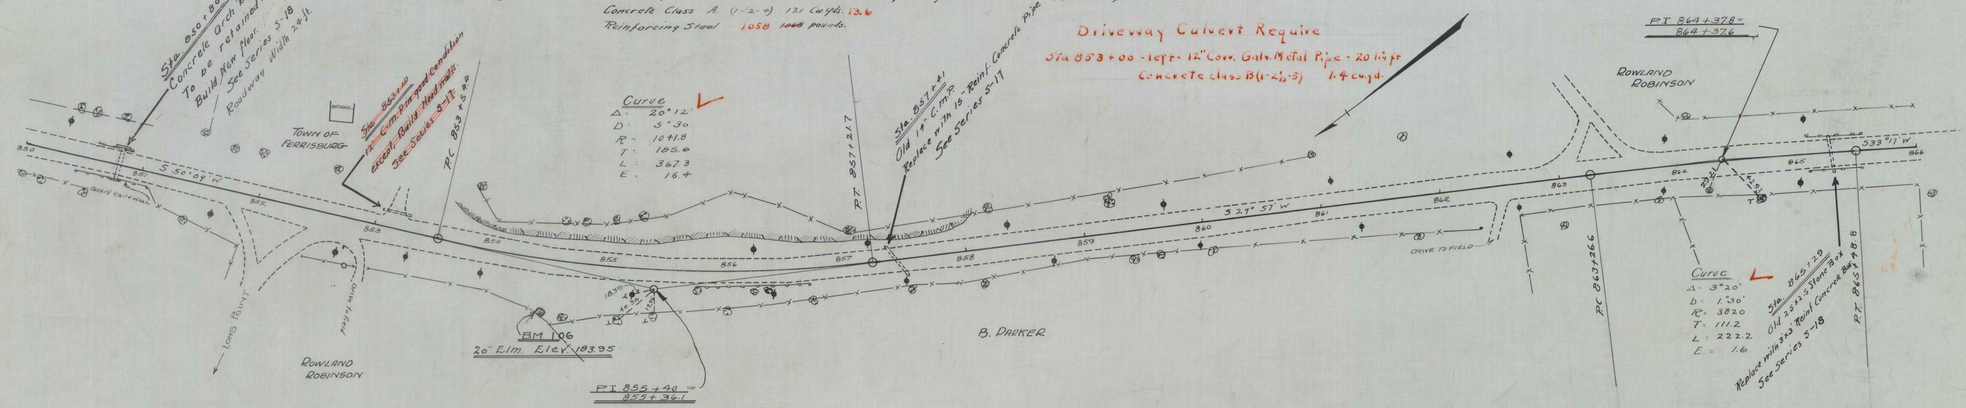

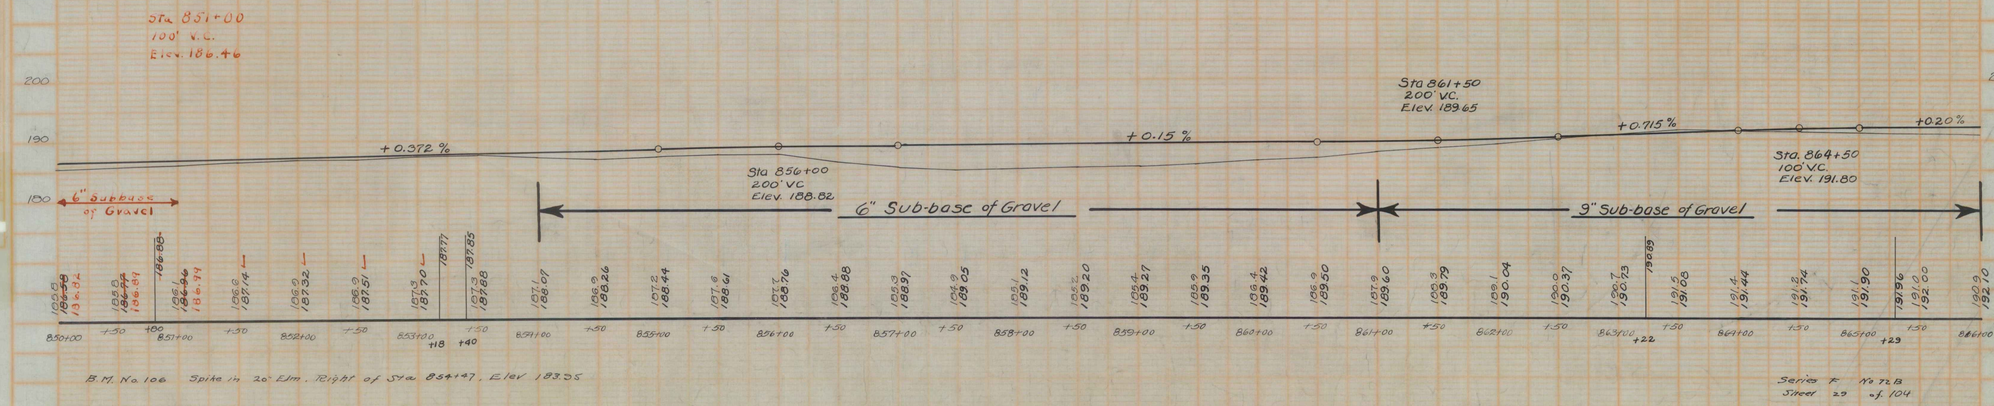

Series F No 728
Sheet 29 of 104