FED. ROAD DIST. NO.	STATE	FED. AID PROJ. NO.	FISCAL YEAR	SHEET NO.	TOTAL SHEETS
9	VT.	72 B.	1928	7	104

WOOD GUARD RAIL REQUIRED

LEFT

Sta.	529+76 to	530+00	Length	24 ft.
"	517+18 -	517+42	"	24 "
"	523+98 -	524+22	"	24 "

RIGHT

Sta. 529+76 to Sta. 530+00 - Length 24 ft.

CABLE GUARD RAIL REQUIRED.

LEFT

~~Sta 517+18 to 517+42 Length 24 ft~~

~~" 523+98 " 524+22 " 24 "~~

RIGHT

Sta.	517+00 to 519+24	Length	224 ft.
"	524+00 to 526+00	"	200 ft.

NEW CULVERTS REQUIRED.

Sta. ~~517+30~~	~~18" Reinf. Concrete Pipe Culvert~~	~~60 Lin. ft.~~	
	~~Concrete Class A (1-2-4)~~	~~1.0 Cu. yds~~	With Drop Inlet
	~~Concrete Class B. (1-2½-5)~~	~~1.4 Cu. yds.~~	
	~~Reinforcing Steel~~	~~106 pounds~~	
Sta. 524+10	24" Reinf. Concrete Pipe Culvert	56 ~~32~~ Lin. ft.	
	Concrete Class A (1-2-4)	4.7 ~~1.0~~ Cu. yds.	With Drop Inlet
	Concrete Class B. (1-2½-5)	~~1.4 Cu. yds.~~	
	Reinforcing Steel	106 pounds	
Sta. 529+89	18" Reinf. Concrete Pipe Culvert	32 Lin. ft.	
	Concrete Class B-(1-2½-5)	27 Cu. yds	
	Reinforcing Steel	33 pounds	

SUB-BASE OF GRAVEL REQUIRED

Sta. 516+50 to 527+00 = 9" Gravel Sub-base of gravel 1150 Lin. ft.

" 527+00 " 530+00 = 6" " " " " " 300 Lin ft.

CONCRETE CRIBBING REQUIRED.

Sta. 516+25 to 521+75 (left) Length 550 Lin. ft.

GROUTED COBBLE GUTTER REQUIRED

Sta. 516+25 to Sta. 522+75 (Left) 325 sq. yds.

H. W. M. 12/26

A. A. D. 12/26

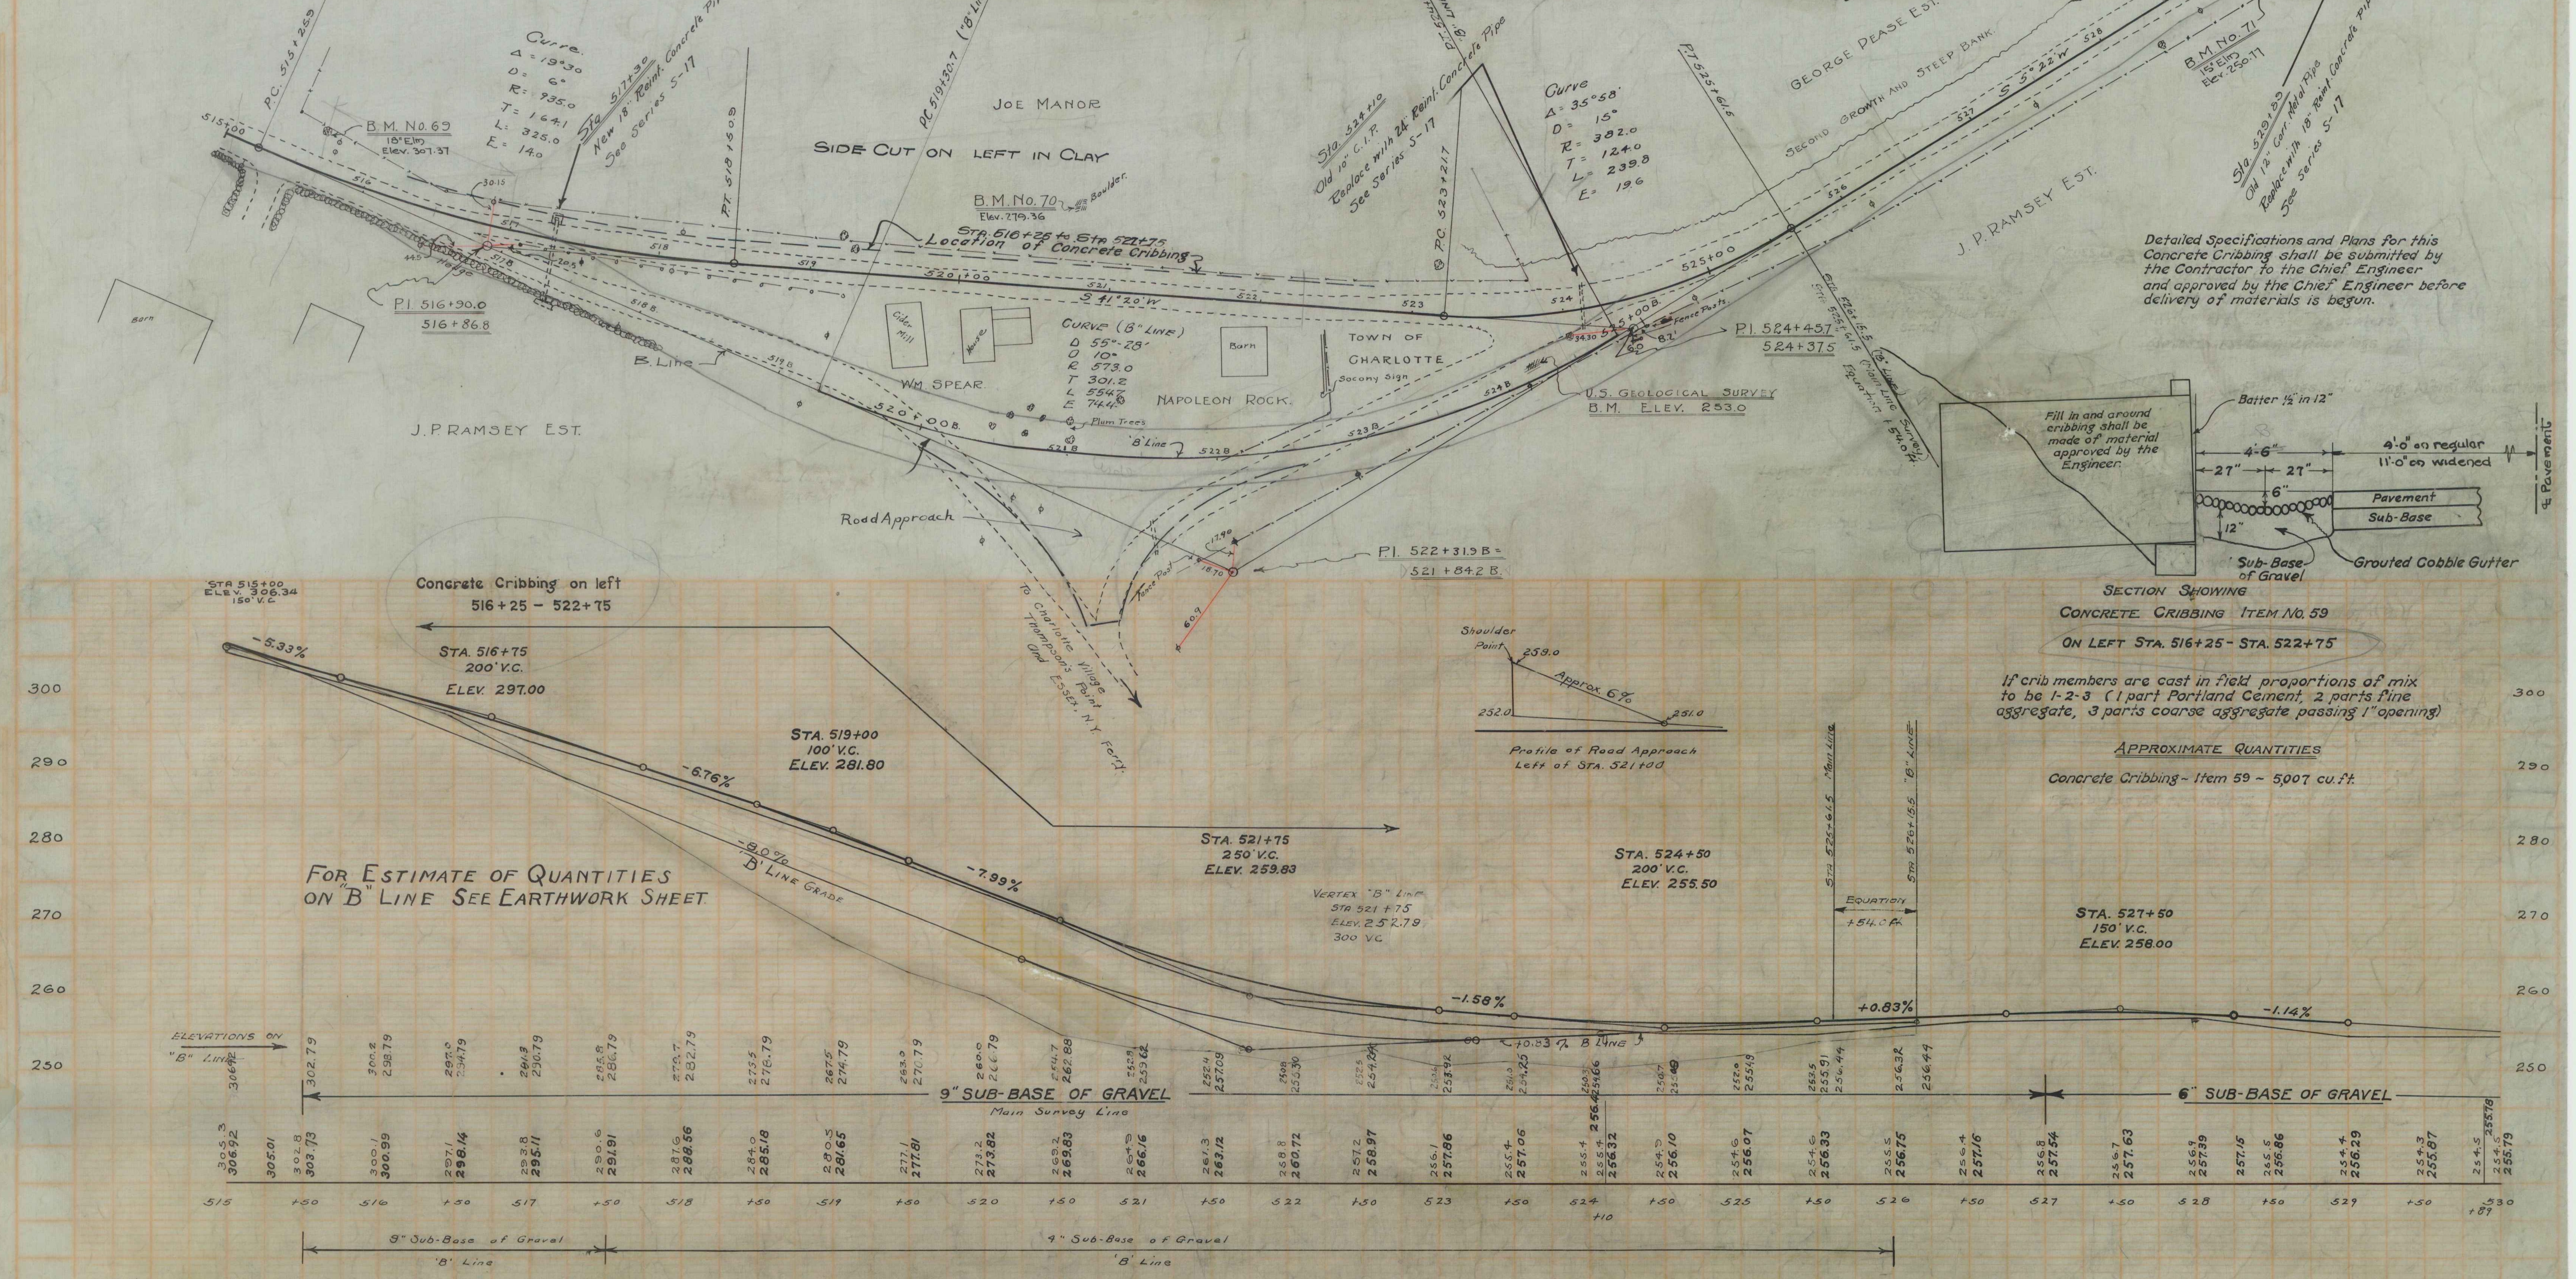

Detailed Specifications and Plans for this Concrete Cribbing shall be submitted by the Contractor to the Chief Engineer and approved by the Chief Engineer before delivery of materials is begun.

SECTION SHOWING
CONCRETE CRIBBING ITEM No. 59
ON LEFT STA. 516+25 - STA. 522+75

If crib members are cast in field proportions of mix to be 1-2-3 (1 part Portland Cement, 2 parts fine aggregate, 3 parts coarse aggregate passing 1" opening)

APPROXIMATE QUANTITIES

Concrete Cribbing ~ Item 59 ~ 5,007 cu. ft.

FOR ESTIMATE OF QUANTITIES ON "B" LINE SEE EARTHWORK SHEET.

B. M. No. 69. Spike in 18" Elm, Left of Sta. 515+62, Elev. 307.37

B. M. No. 70 Boulder in field, Left of Sta. 520+75 Elev. 279.36

B. M. No. 71 Spike in 15" Elm. Right of Sta. 529+17 Elev. 250.77

Series F No. 72 B

Sheet 7 of 104