FED. ROAD DIST. NO.	STATE	FED. AID PROJ. NO.	FISCAL YEAR	SHEET NO.	TOTAL SHEETS
9	VT.	72 B.	1928	8	104

WOOD GUARD RAIL REQUIRED.

LEFT

Sta.	542+38 to	543+12	Length	24 ft.
"	535+38 "	535+62	"	24 "

RIGHT

Sta	542+38 to	543+12	Length	24 ft.
"	535+38 "	535+62	"	24 "

NEW CULVERTS REQUIRED.

Sta. 543+00	18" Reinf. Concrete Pipe Culvert	32 Lin. ft.	
	Concrete Class A (1-2-4)	2.7 Cu. Yds.	2.5
	Reinforcing Steel	54 ~~54~~ Pounds.	
Sta. 535+50	15" Reinf. Conc. Pipe Culvert	32 lin. ft	
	Concrete Class A (1-2-4)	2.5 Cu. Yds	
	Reinforcing Steel	54 lbs	


SUB-BASE OF GRAVEL REQUIRED.

Sta. 530+00 to 533+00 - 6" Sub-base of gravel ~~300~~ Lin. ft
545+00 1500 "

Driveway Culverts

Sta 537+16 - left - Relay 25ft of pipe
Concrete Class B (1-2½-5') 1.4 Cu Yds

Sta 538+00 left - Relay 20 ft of pipe
Concrete class B (1-2½-5') 1.4 " "

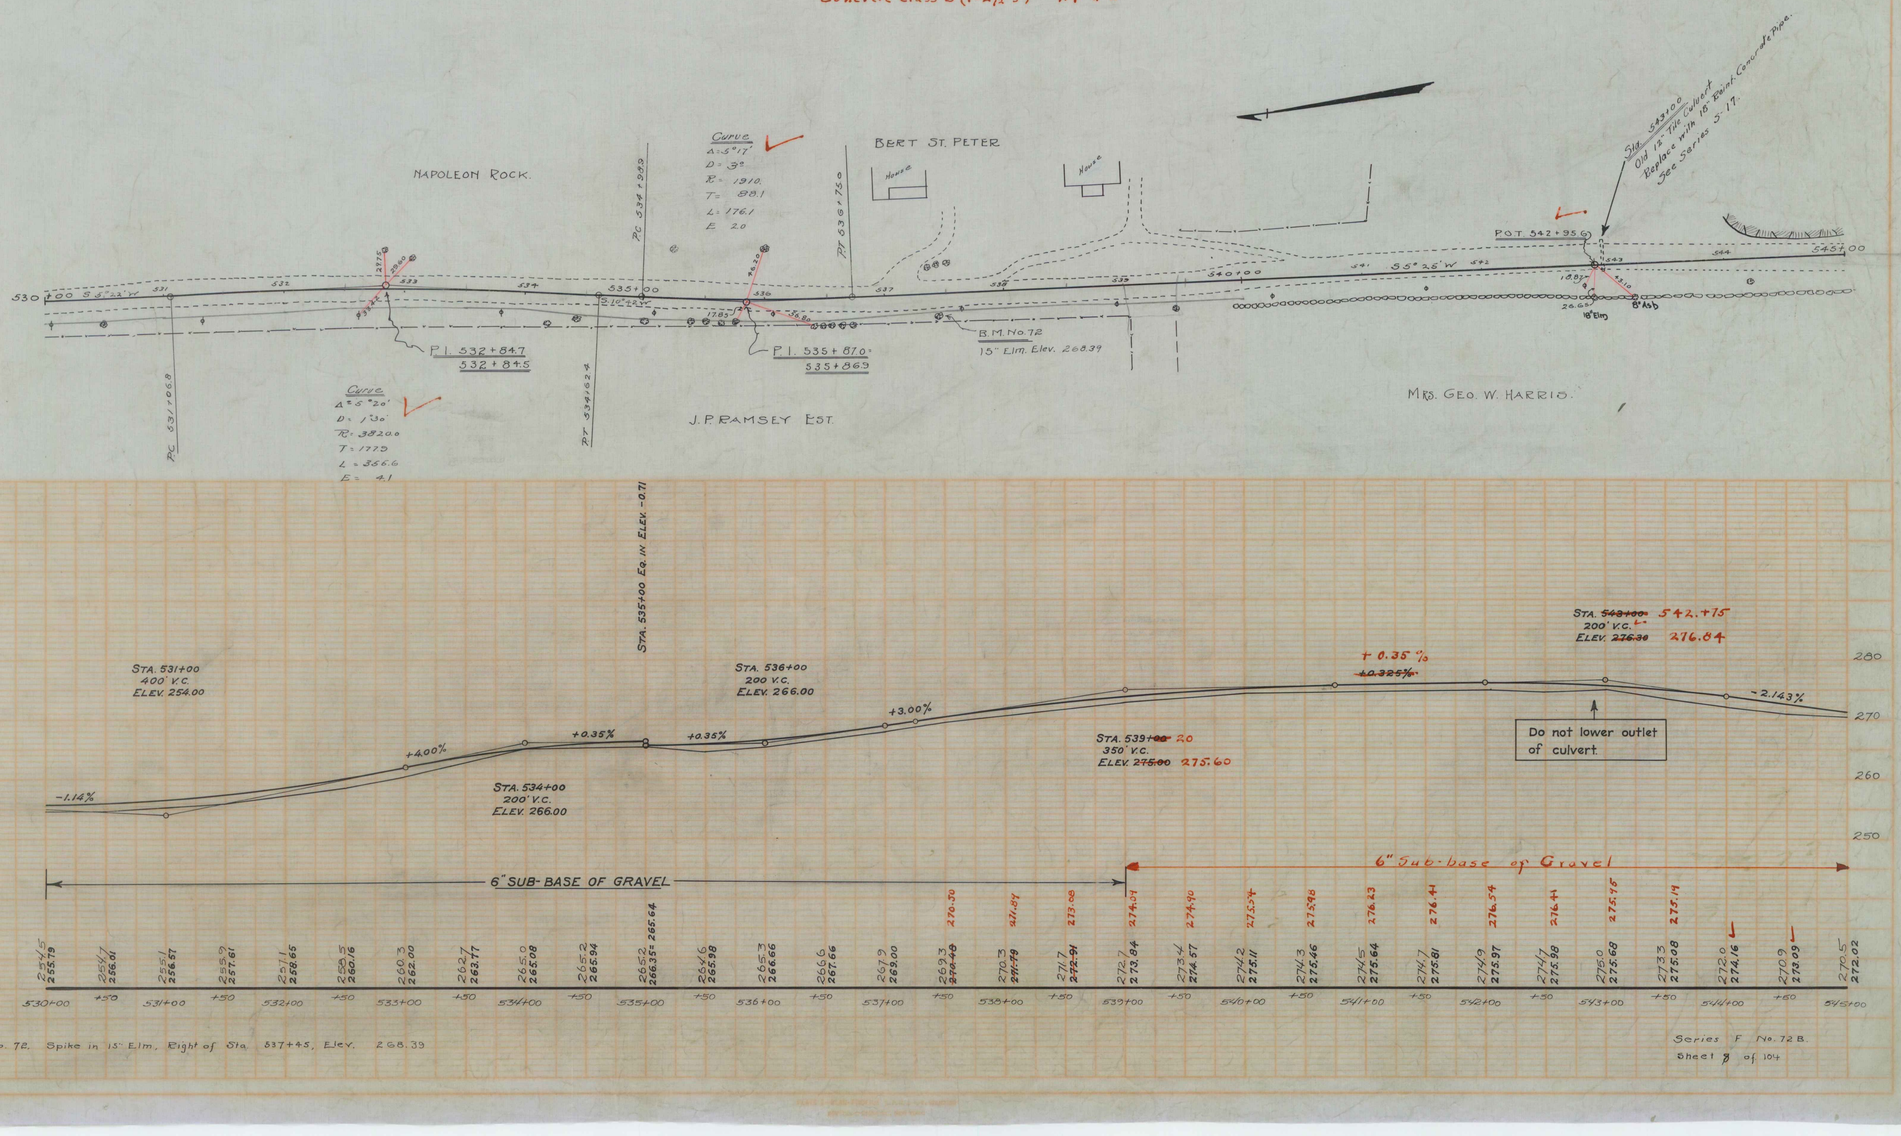

B.M. No. 72. Spike in 15" Elm, East of Sta. 537+45, Elev. 268.39

Series F No. 72 B.
Sheet 8 of 104