FED. ROAD DIST. NO.	STATE	FED. AID PROJ. NO.	FISCAL YEAR	SHEET NO.	TOTAL SHEETS
9	VT.	72 B.	1928	11	184

WOOD GUARD RAIL REQUIRED.

		LEFT		
Sta.	575+50 to	575+74	Length	24 ft.
"	588+17 "	588+41	"	24 "
"	582+88 "	583+12	"	24"
		Right		
Sta.	575+50 to	575+74	Length	24 ft.
"	588+17 "	588+41	"	24 "
"	582+88 "	583+12	"	24"

NEW CULVERTS REQUIRED

Sta. 575+62	18" Reinf. Concrete Pipe Culvert	32	Lin. ft
	Concrete Class A (1-2-4)	2.4	2.7 Cu. Yds.
	Reinforcing Steel	54	60 pounds.
Sta. 588+29	18" Reinf. Concrete Pipe Culvert	36	38 Lin. ft.
	Concrete Class A (1-2-4)	2.4	2.7 Cu. Yds.
	Reinforcing Steel	54	60 pounds.
Sta. 582+56	18" Reinf. Conc. Pipe Culvert	32	Lin ft
	Concrete Class A (1-2-4)	2.4	cu yds
	Reinforcing Steel	54	163

SUB-BASE OF GRAVEL REQUIRED.

~~Sta. 578+00 to 580+00 6" Sub-base of gravel 100 Lin ft~~

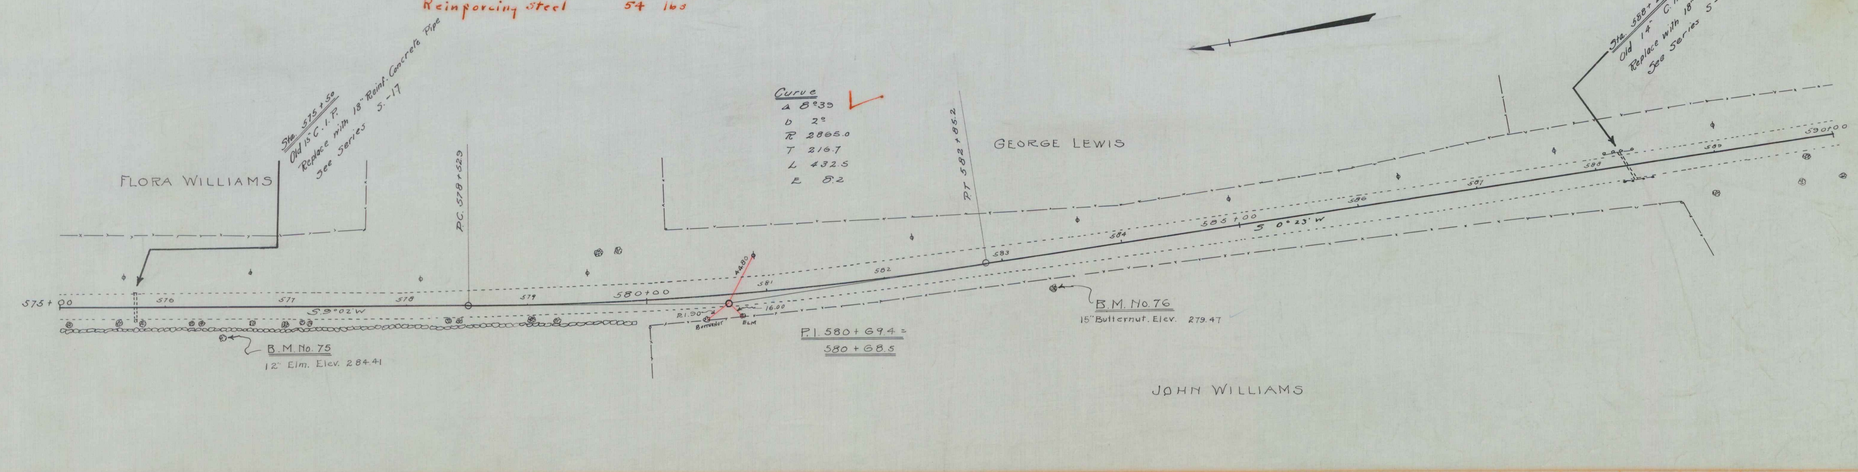

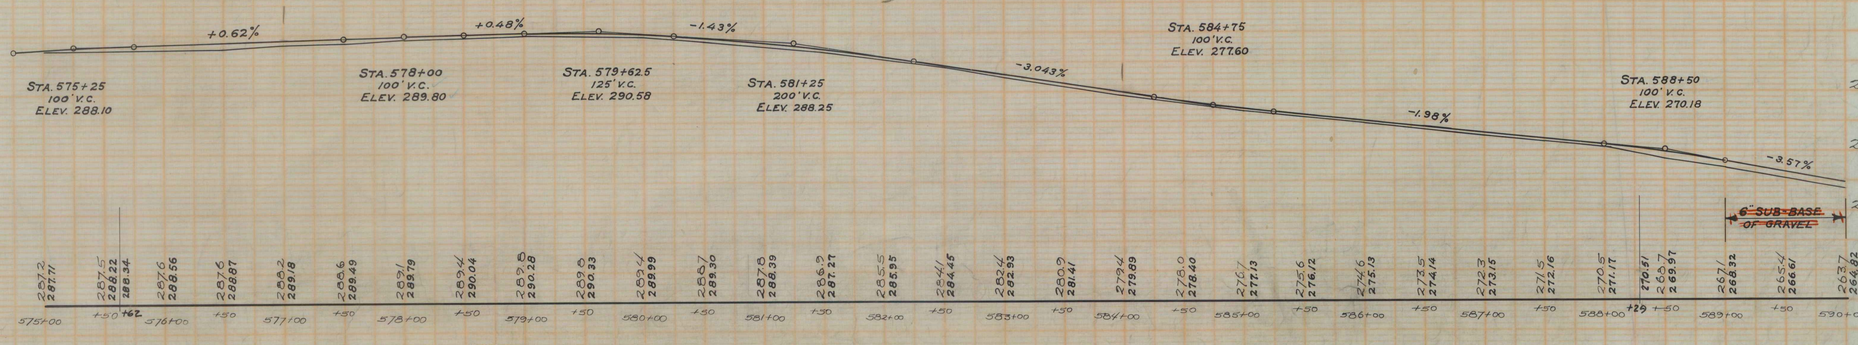

B.M. No. 75 Spike in 12" Elm. Right of Sta. 576+49. Elev. 284.41
B.M. No. 76 Spike in 15" Butternut Right of Sta. 583+38 Elev. 279.47

Series F. No. 728.
Sheet 11 of 184