FED. ROAD DIST. NO.	STATE	FED. AID PROJ. NO.	FISCAL YEAR	SHEET NO.	TOTAL SHEETS
5	VT.	728	1928	17	104

WOOD GUARD RAIL REQUIRED.

LEFT and Right

Sta. 671+38 to 671+62 Length 48 24 ft.

CABLE GUARD RAIL REQUIRED

Right

~~Sta. 668+00 to 670+48 Length 178 ft~~

~~" 670+75 " 673+23 " 248 "~~

NEW CULVERTS REQUIRED.

Sta. 671+30 - 30" Reinf. Concrete Pipe Culvert 40 Lin. ft.

Concrete Class A (1-2-4) ~~35~~ 34 Cu. yds.

Reinforcing Steel ~~66~~ 54 pounds.

DRIVEWAY CULVERTS REQUIRED

~~Sta. 672+20 Left - 12" Corr. Galv. Metal Pipe 30 Lin. ft~~

~~Concrete Class B (1-2½-5) 1.1 Cu. yds.~~

Sta 675+25 - Right - 12" Corr. Galv. Metal Pipe 36 lin ft

Concrete Class B (1-2½-5) 1.4 Cu yds


" 679+00 - Right - 12" Corr Galv Metal Pipe 20 lin ft


Concrete Class B 1.4 cu yds

SUB BASE OF GRAVEL REQUIRED.

Sta. 668+00 to 676+00 - 6" Sub-base of gravel. 800 Lin. ft

" 676+00 to 680+00 - 9" " " " " 400 " "

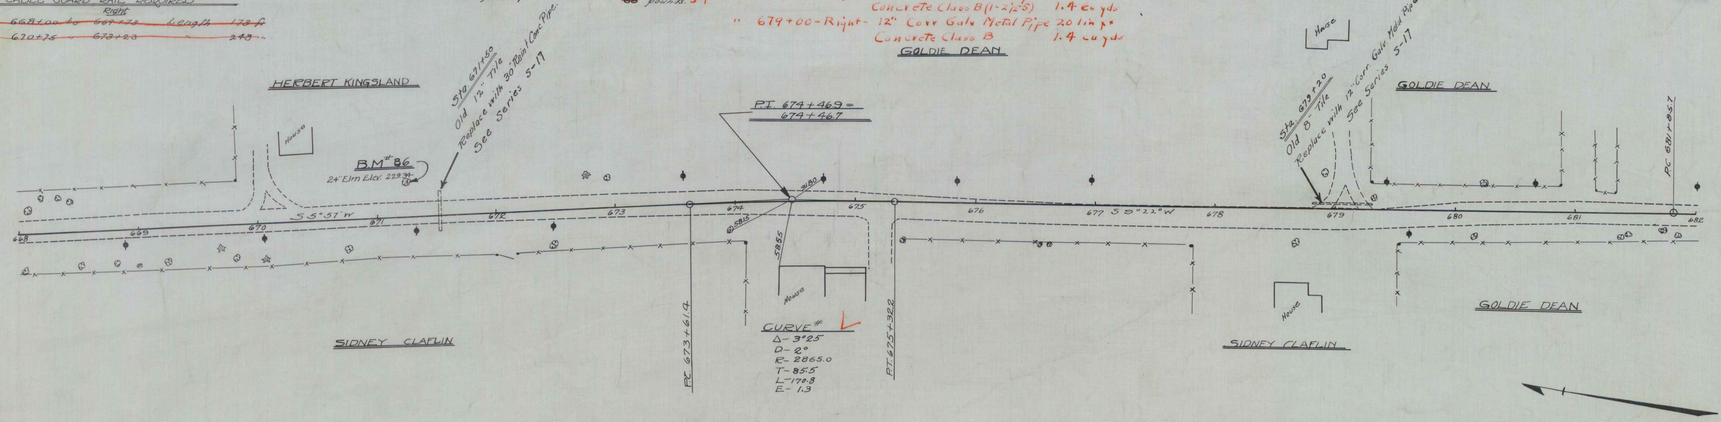

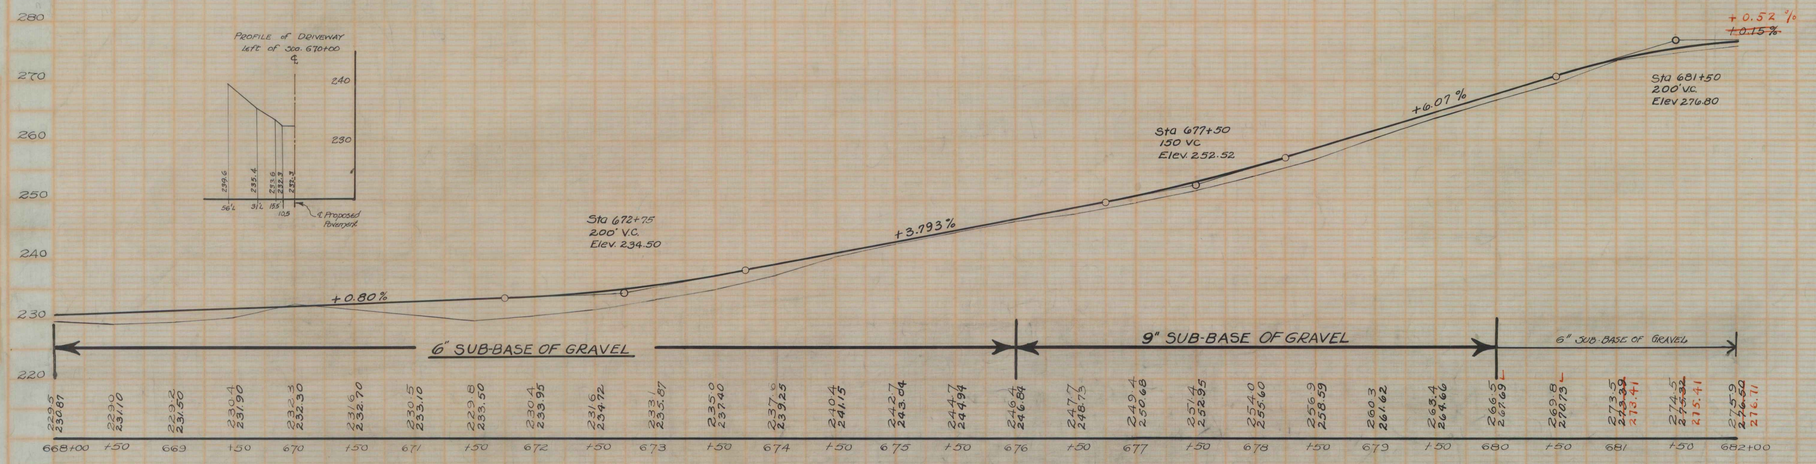

B.M. No. 86 — SPIKE IN 24" ELM, 28' LEFT OF STA. 671+25 ELEV 229.34

SERIES F. NO. 728
SHEET 17 of 104