FED. ROAD DIST. NO.	STATE	FED. AID PROJ. NO.	FISCAL YEAR	SHEET NO.	TOTAL SHEETS
9	VT.	728	1928	22	104


DRIVEWAY CULVERTS REQUIRED.

~~Sta. 730+00 Rt. 12" Corr. Galv. Metal Pipe 20 ft.~~
~~Concrete Class B (1-2½-5) 1.1 Cu. Yds.~~

Sta 744+25 Left - Relay 20 linear ft. of Pipe
Concrete Class B (1-2½-5) 1.4 Cu Yds

SUB-BASE OF GRAVEL REQUIRED.

Sta.	750+50 to 753+00	9" Sub-base of gravel	250 ft.
"	753+00 to 754+00	9" Gravel Shoulder Course	100 ft.
743+50 to 746+00		6" Sub base of gravel	250 ft

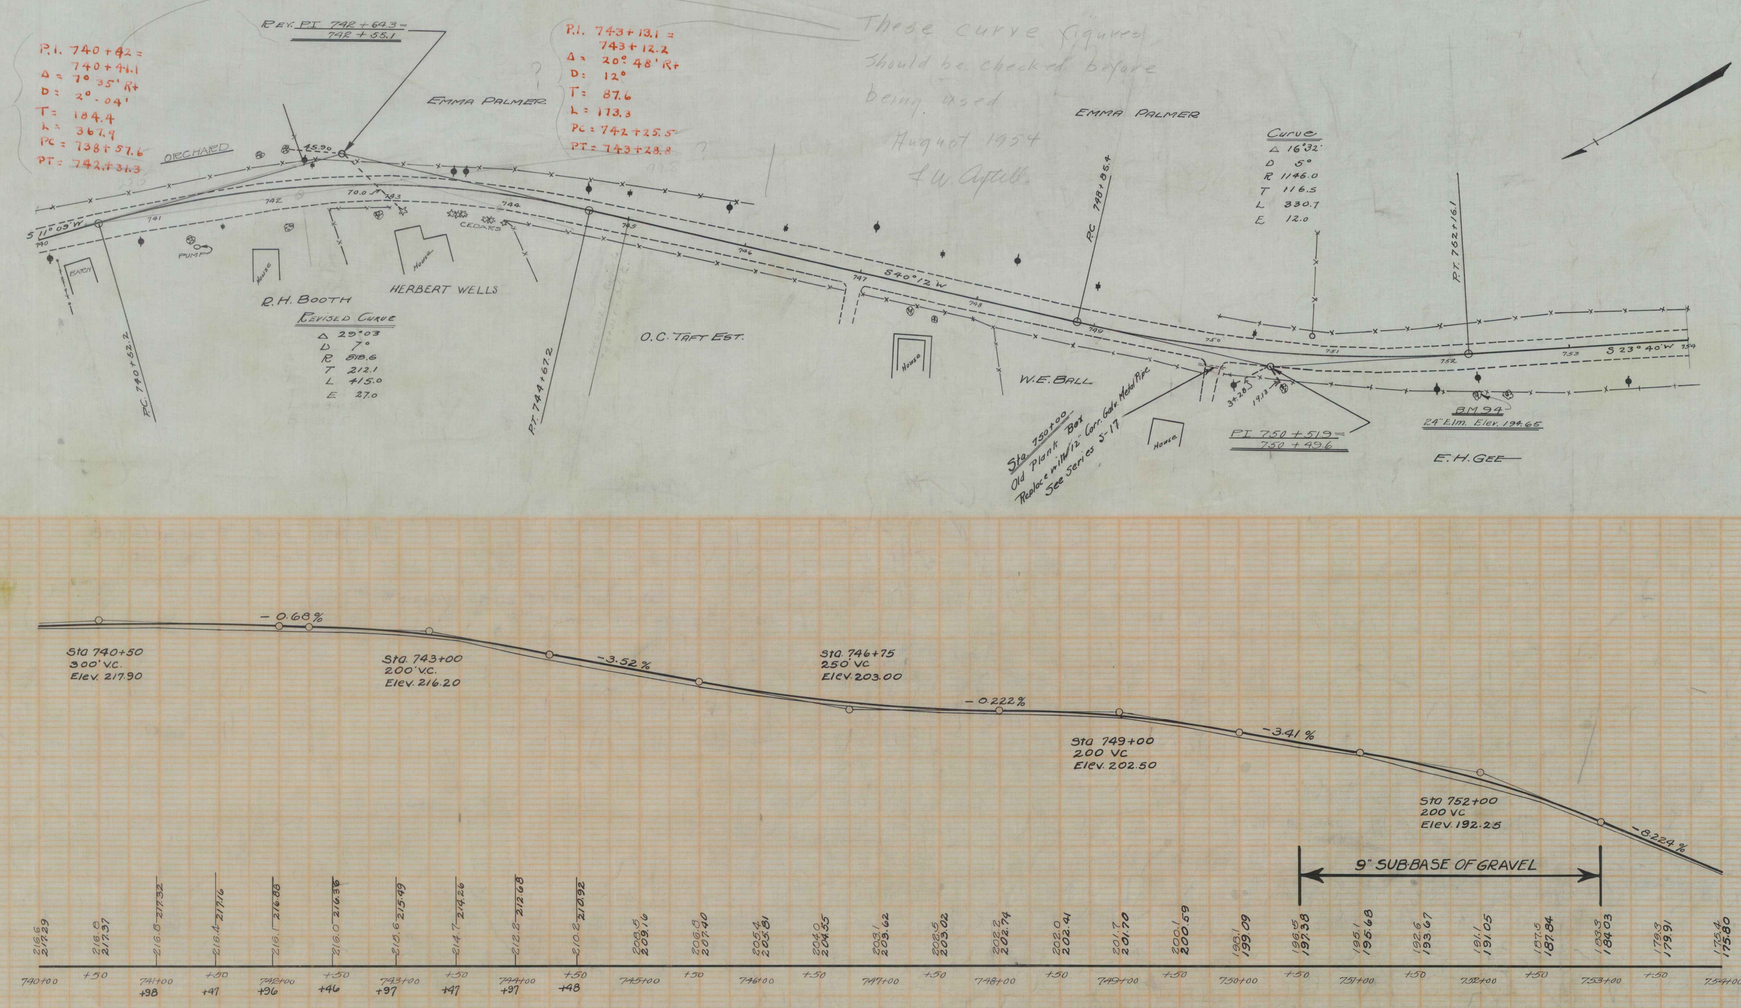

B.M. No. 34 Spike in 27" Elm Tree 41 ft. Rt. of 752+21 Elev. 194.65

Series F No. 728
Sheet 22 of 104