Wood

CABLE GUARD RAIL REQUIRED

	LEFT				
Sta.	804+80 to 12	805+00 60	Length	120	Lin.ft.
	RIGHT			88	
Sta.	804+80 to 48	805+80 60	Length	120	Lin.ft.
				108	

SUB-BASE OF GRAVEL REQUIRED

Sta ~~814+00 to 818+00 Gravel Shoping Course~~ 150 Lin. ft.
817+00 TO 818+00 6" Sub base of Gravel 100

CULVERT REPAIRS REQUIRED

~~Sta. 804+30 Build New Stone~~
~~Concrete Class A (1:2:4) 2 Cu. yds.~~
~~Reinforcing Steel 138 pounds~~

FED. ROAD DIST. NO.	STATE	FED. AID PROJ. NO.	FISCAL YEAR	SHEET NO.	TOTAL SHEETS
2			1928	26	104

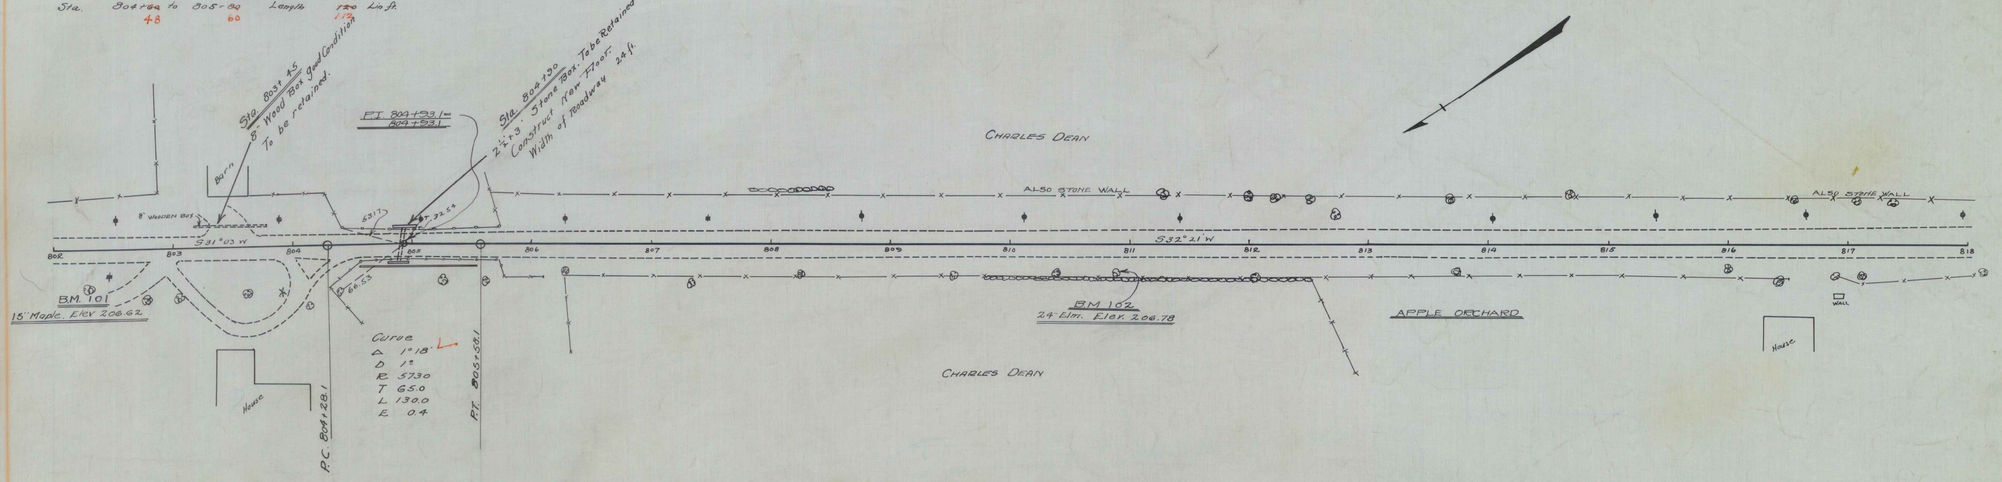

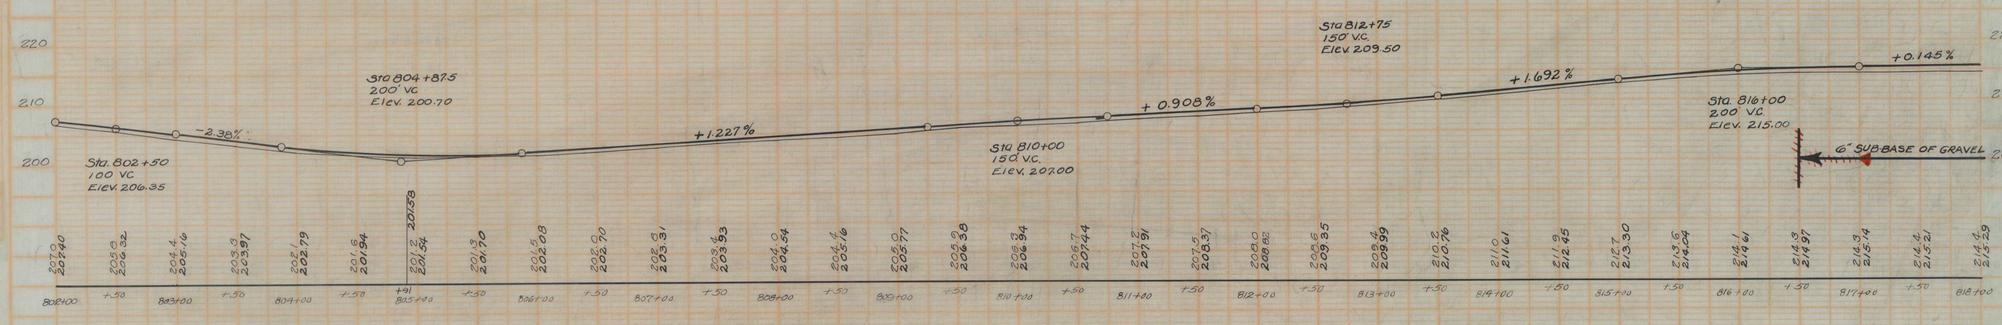

B.M. No. 101 Spike in 15" Maple Right of Sta. 802+46, Elev. 206.62
B.M. No. 102 " " 24" Elm " " " 810+83 Elev. 206.78

Series F No. 728
Sheet 26 of 104