
FED. ROAD DIST. NO.	STATE	FED. AID PROJ. NO.	FISCAL YEAR	SHEET NO.	TOTAL SHEETS
		728	1928	12	104


DRIVEWAY CULVERTS REQUIRED

Sta. 591+90 Right, 12" Corr. Galv. Metal Pipe 32 Lin. ft.
Concrete Class B (1-2¼-3) 1.4 Cu. yd.
" 593+60 Right 12" Corr. Galv. Metal Pipe 20 Lin. ft.
Concrete Class B (1-2¼-3) 1.4 Cu. yds.

SUB-BASE OF GRAVEL REQUIRED

Sta 590+00 to 595+00 - 6" Sub-base of gravel 500 Lin ft

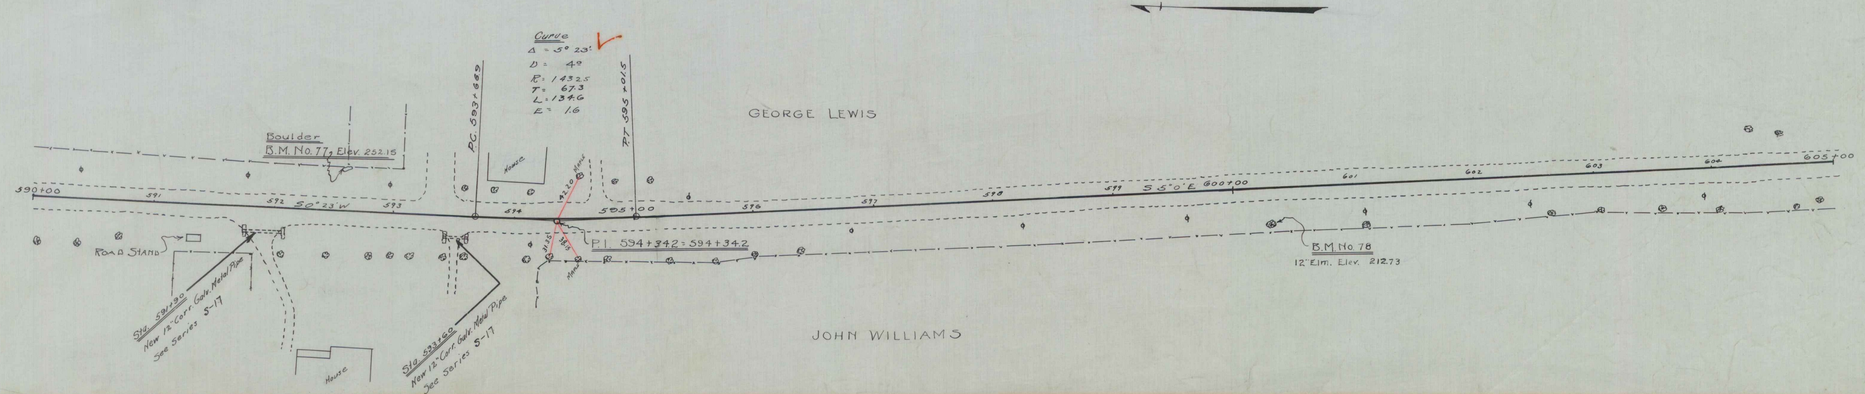

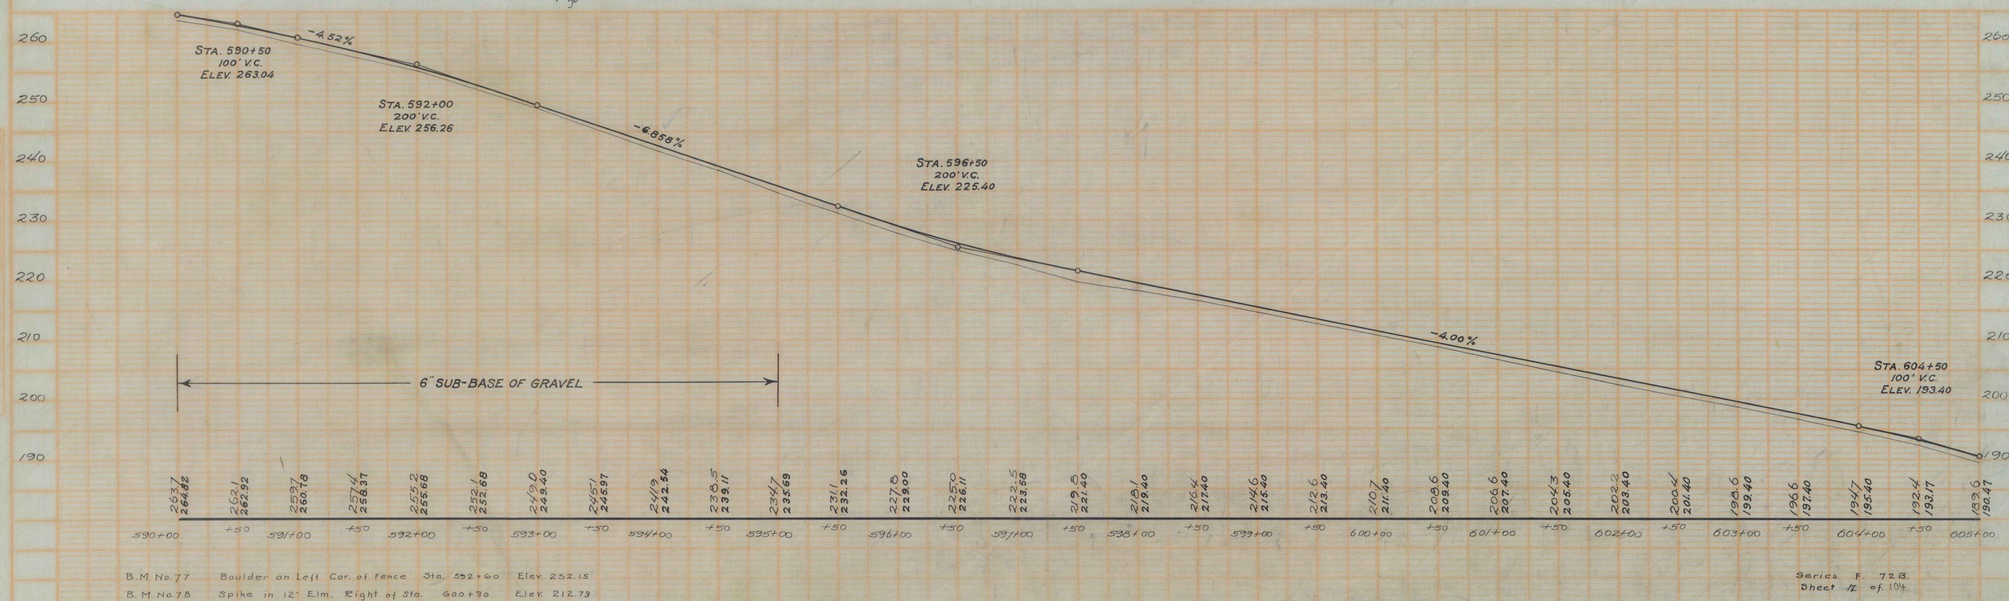

B.M. No. 77 Boulder on Left Cor. of fence Sta. 592+60 Elev. 252.15
B.M. No. 78 Spike in 12" Elm. Right of Sta. 600+30 Elev. 212.73

Series F. 72.13.
Sheet 12 of 104