SUB-BASE OF GRAVEL REQUIRED

Sta. 770+00 772+60 - 12" Sub-base of gravel 350 ~~200~~ Lin. ft.
773+80

" 785+00 786+00 6" " " " " 100 " "

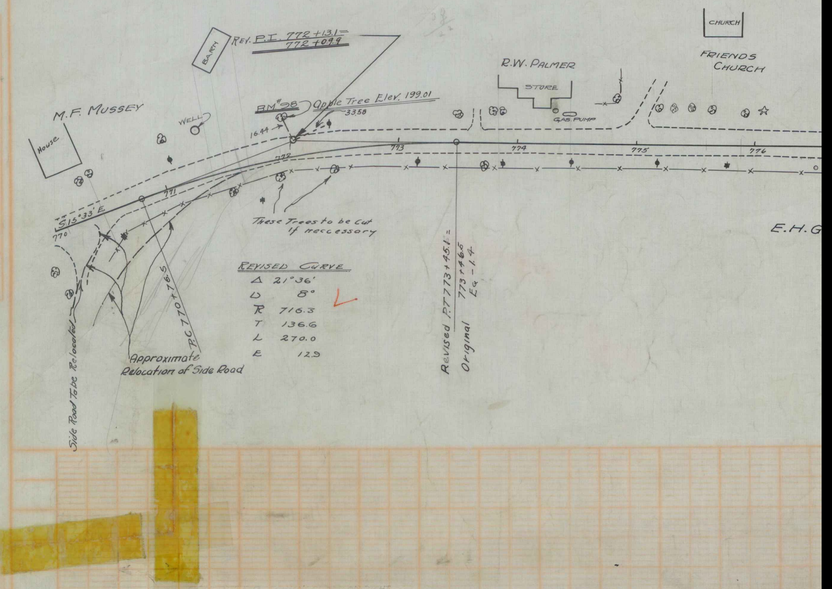

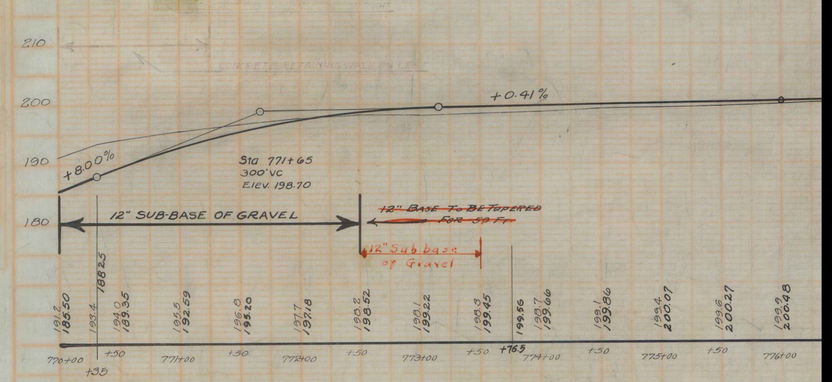

B.M. No 98 Spike in Apple Tree Left of Sta. 772+08 Elev 198.01
B.M. No 99 " " 24" Pine Left " " 779+39 Elev. 205.10