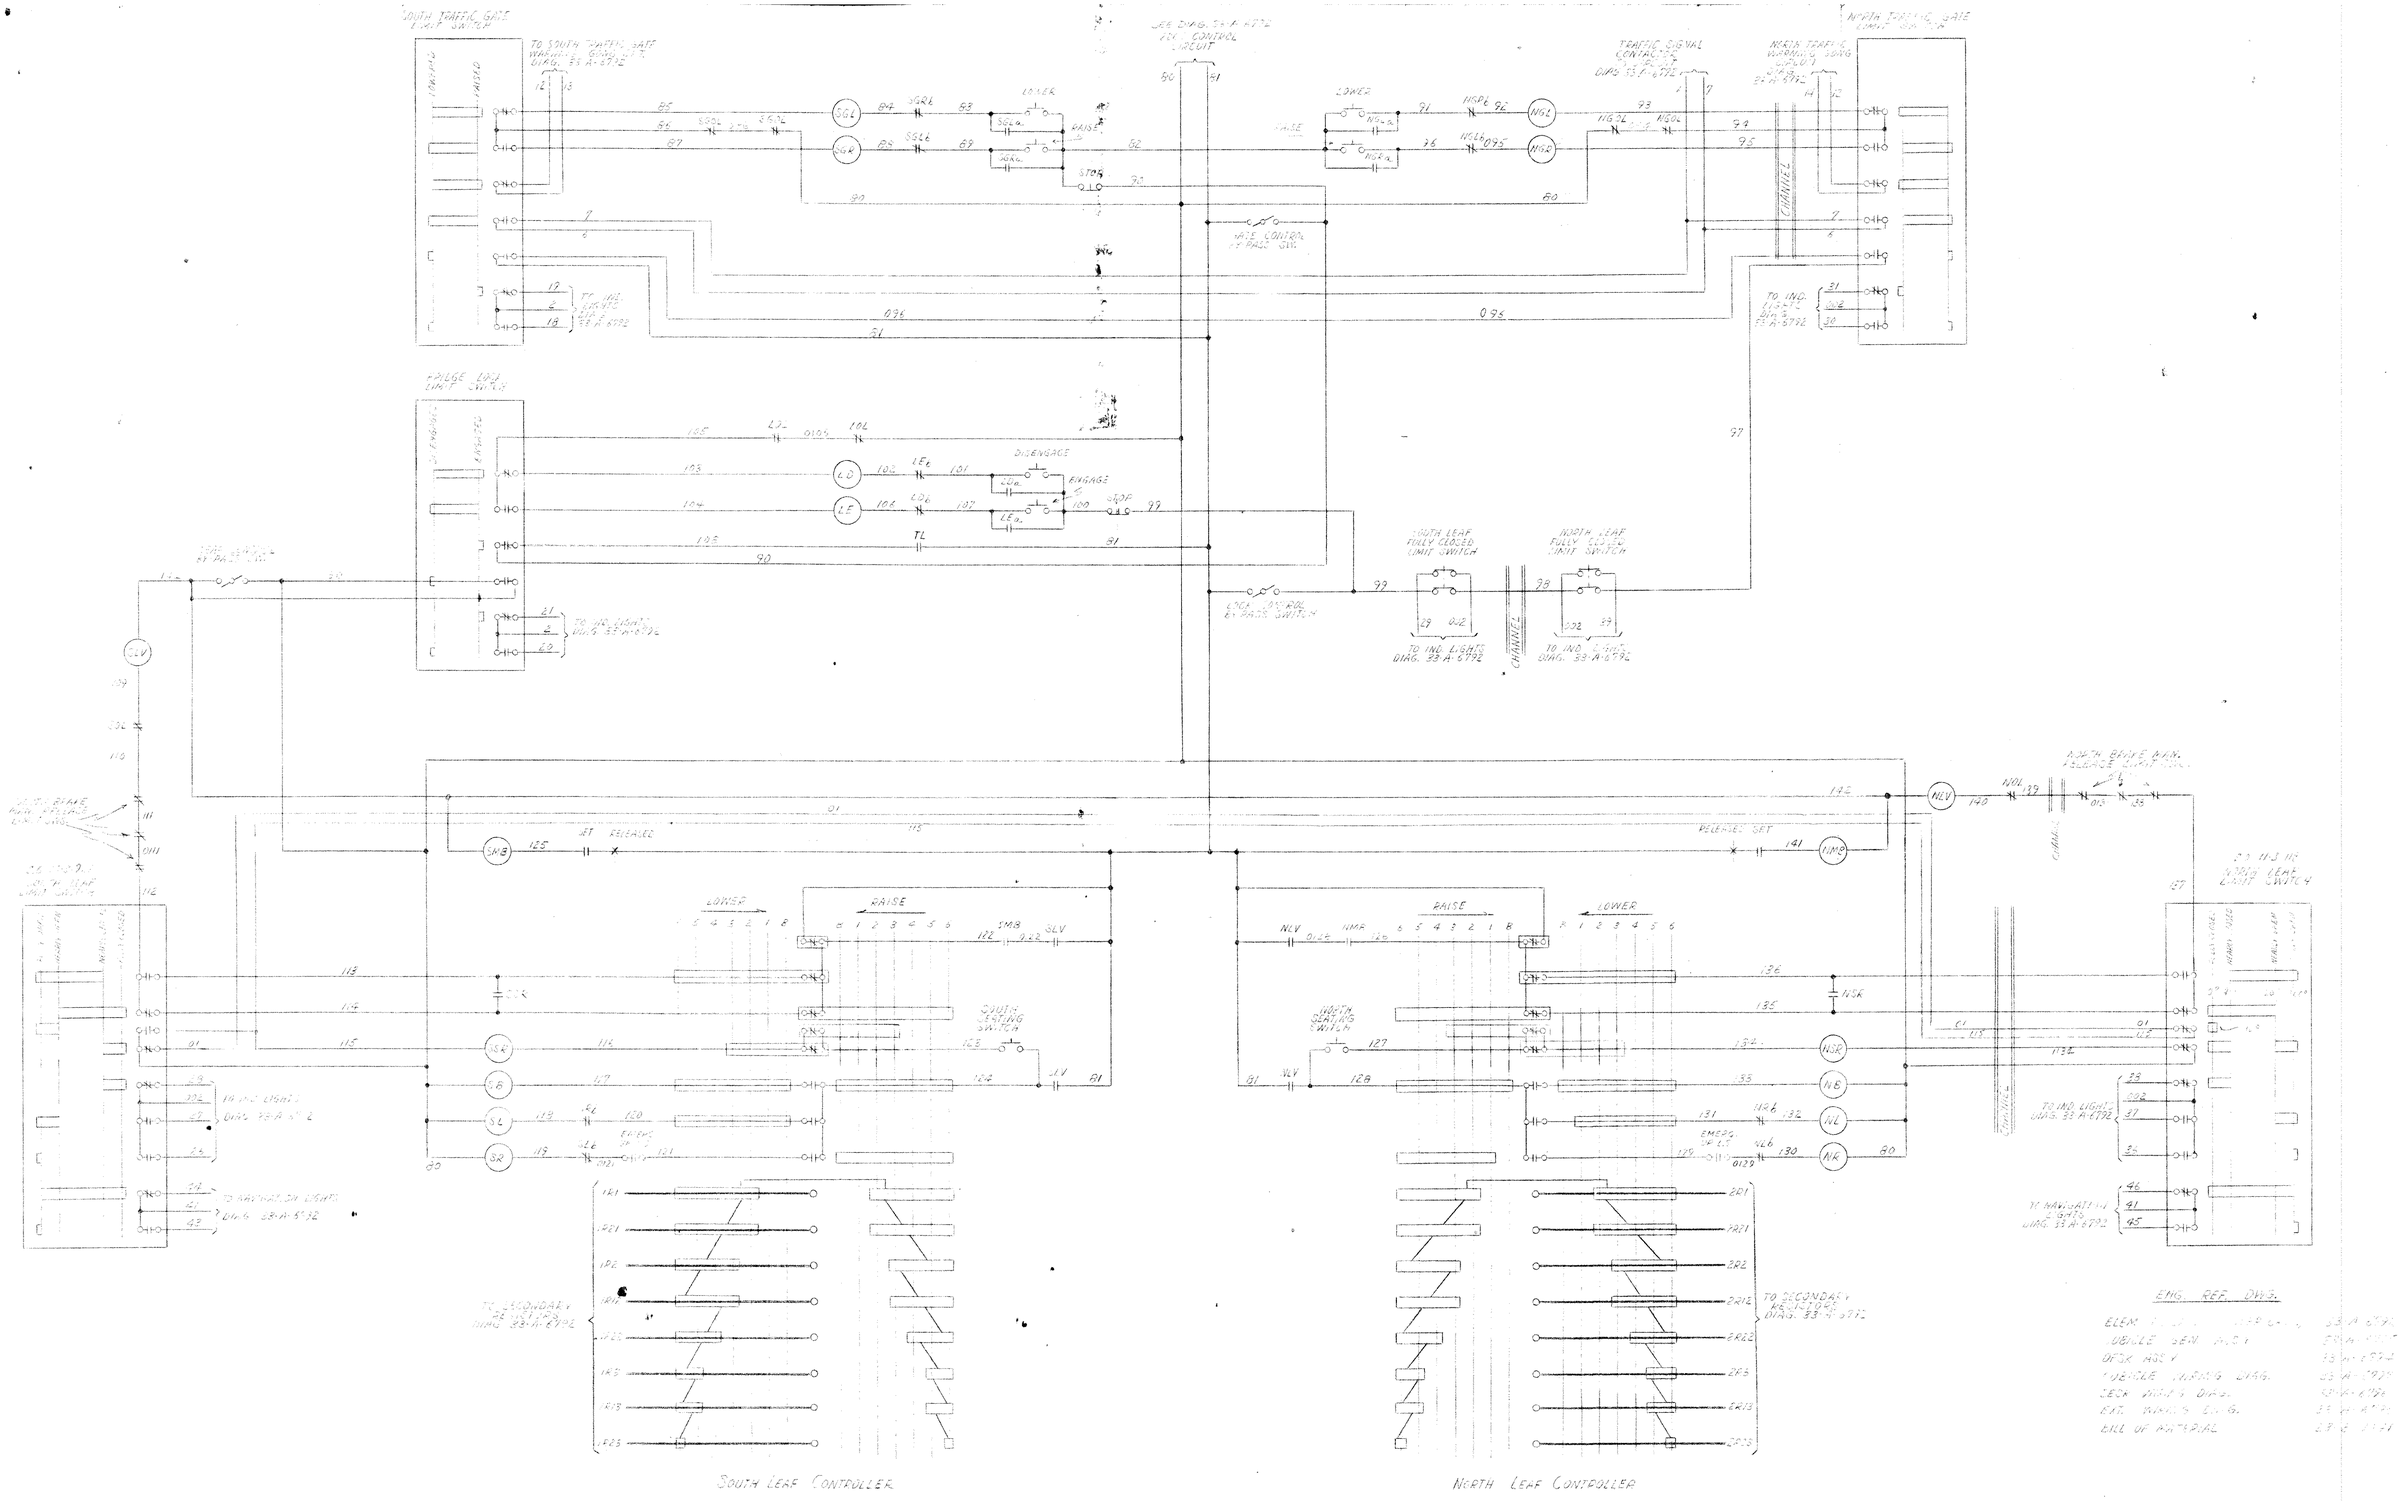

S.O.		1
D.		
IT.	CHANGE	

WESTINGHOUSE ELECTRIC CORPORATION

TITLE ELEMENTARY CONTROLLER DIAGRAM
GRAND ISLAND - NORTH HERO BRIDGE [illegible]
CONTROL CIRCUIT

DFTM. [illegible]	11/20/50	APPD. [illegible]	11/20/50
CHKD. [illegible]	11/20/50	APPD. [illegible]	7/27/50
DIV. & PLANT LOCATION	[illegible]		

33-A-6793

TOOL REF. DWG. | ENG. REF. DWG.

BUFFALO DIVISIONS, BUFFALO N.Y., U.S.A.

ENG. DEPT. FORM NO. 18166-A

PENCIL TRACING CLOTH