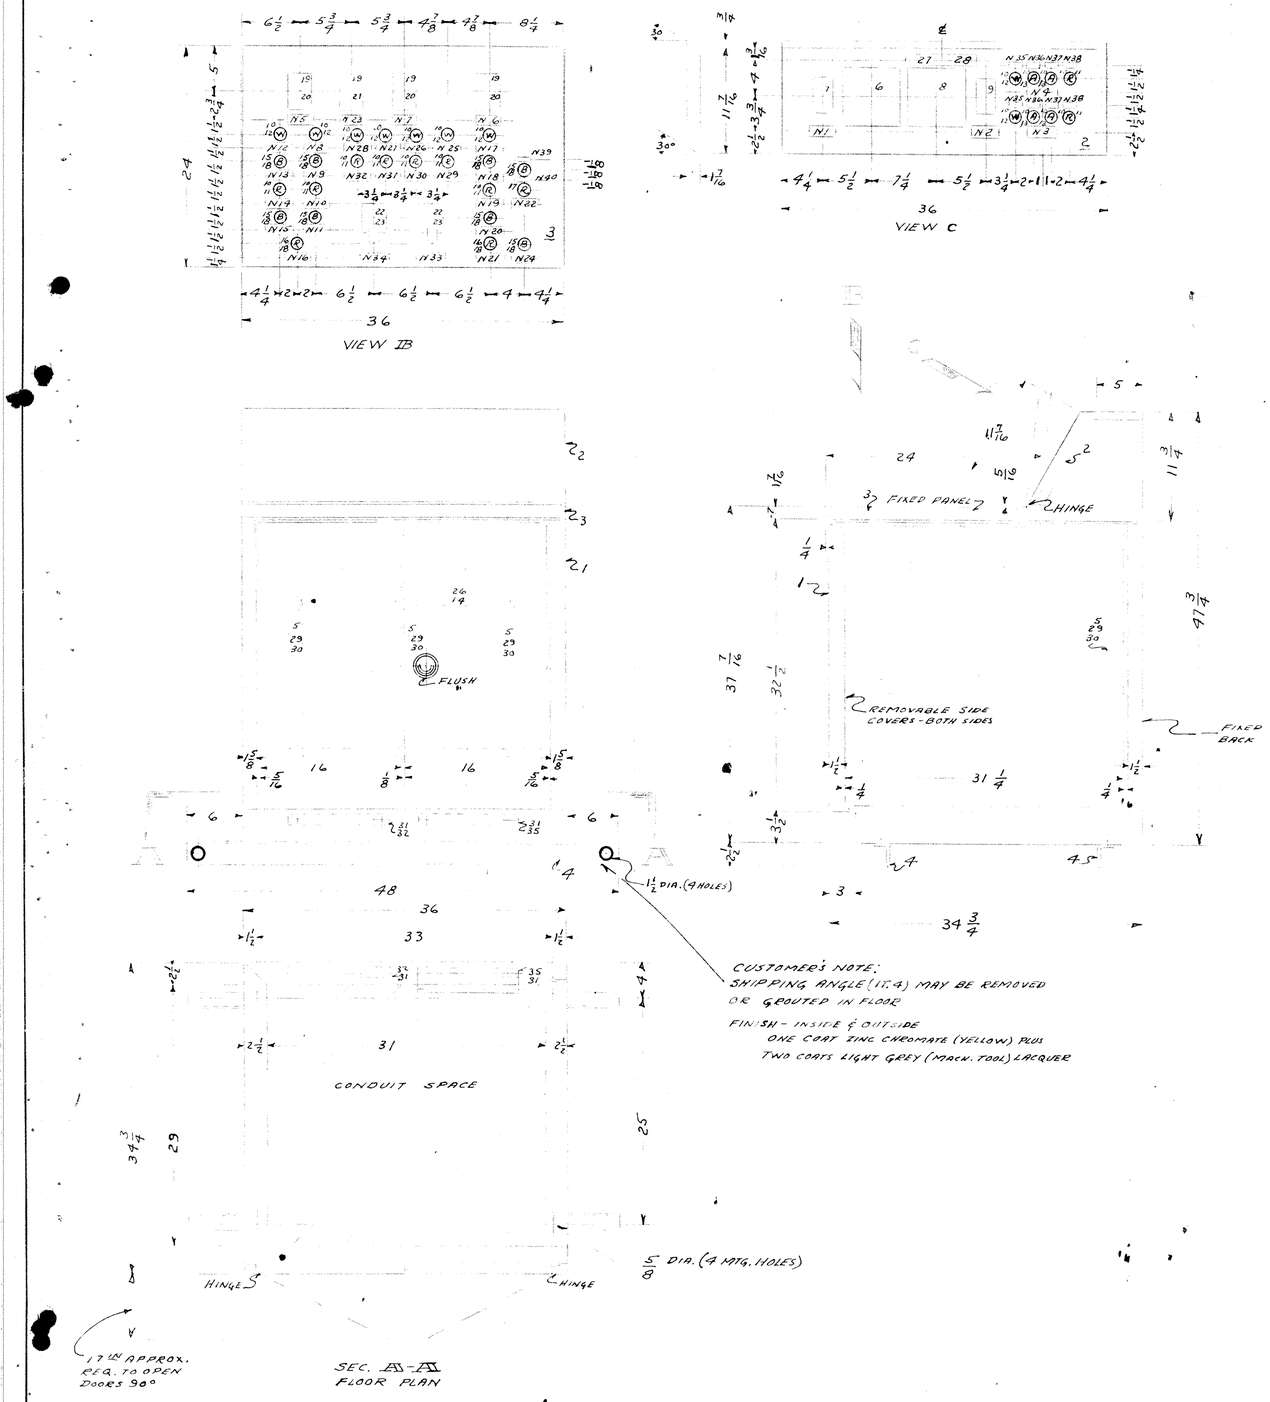

ITEM	PART NO.	SECTION	TOTAL REQ.	EXCEPTIONS PER DWG. 7-D-1932 FIG. NO.	REQ.

APPARATUS

DWG. SUB. 1284 FINISH CHART NONE

SYM.	ITEM	DESCRIPTION — MATERIAL — REF. DWG. DIMENSIONS IN INCHES	FINE CH. LINE NO.	STYLE No.	PAT. NO.	REQ.	TOOL RECORD SPACE

CONTINUED ON SHEET 2

SYM.	ITEM	DESCRIPTION — MATERIAL — REF. DWG. DIMENSIONS IN INCHES	FINE CH. LINE NO.	STYLE No.	PAT. NO.	REQ.	TOOL RECORD SPACE

★ NEW
Z NEW
+ NEW
ϕ REMOVE N.P. & USE IT. 23

S.O. 24-5-84	1	CHANGE			
S.O. 24-5-84	2	PICTURE VIEW C			
S.O. 24-5-84	★ 3				
S.O. 24-5-84	4				

WESTINGHOUSE ELECTRIC CORPORATION

TITLE

DIMENSIONS IN INCHES—SCALE 1/8 = 1

DFTM. H.F. DAVIS 11/8/50 APPD. J.E. Thomas 11/8/50

APPD. 11/10/50

CHKD. H.F.D. 11/8/50

DIV. & PLANT LOCATION IND. CONTROL, BUFFALO DIV., BUFFALO, N.Y., U.S.A.

33-A-6794

TOOL REF. DWG. ENG. REF. DWG.

PITTSBURGH PENCIL TRACING CLOTH

ENG. DEPT. FORM NO. 18163-A