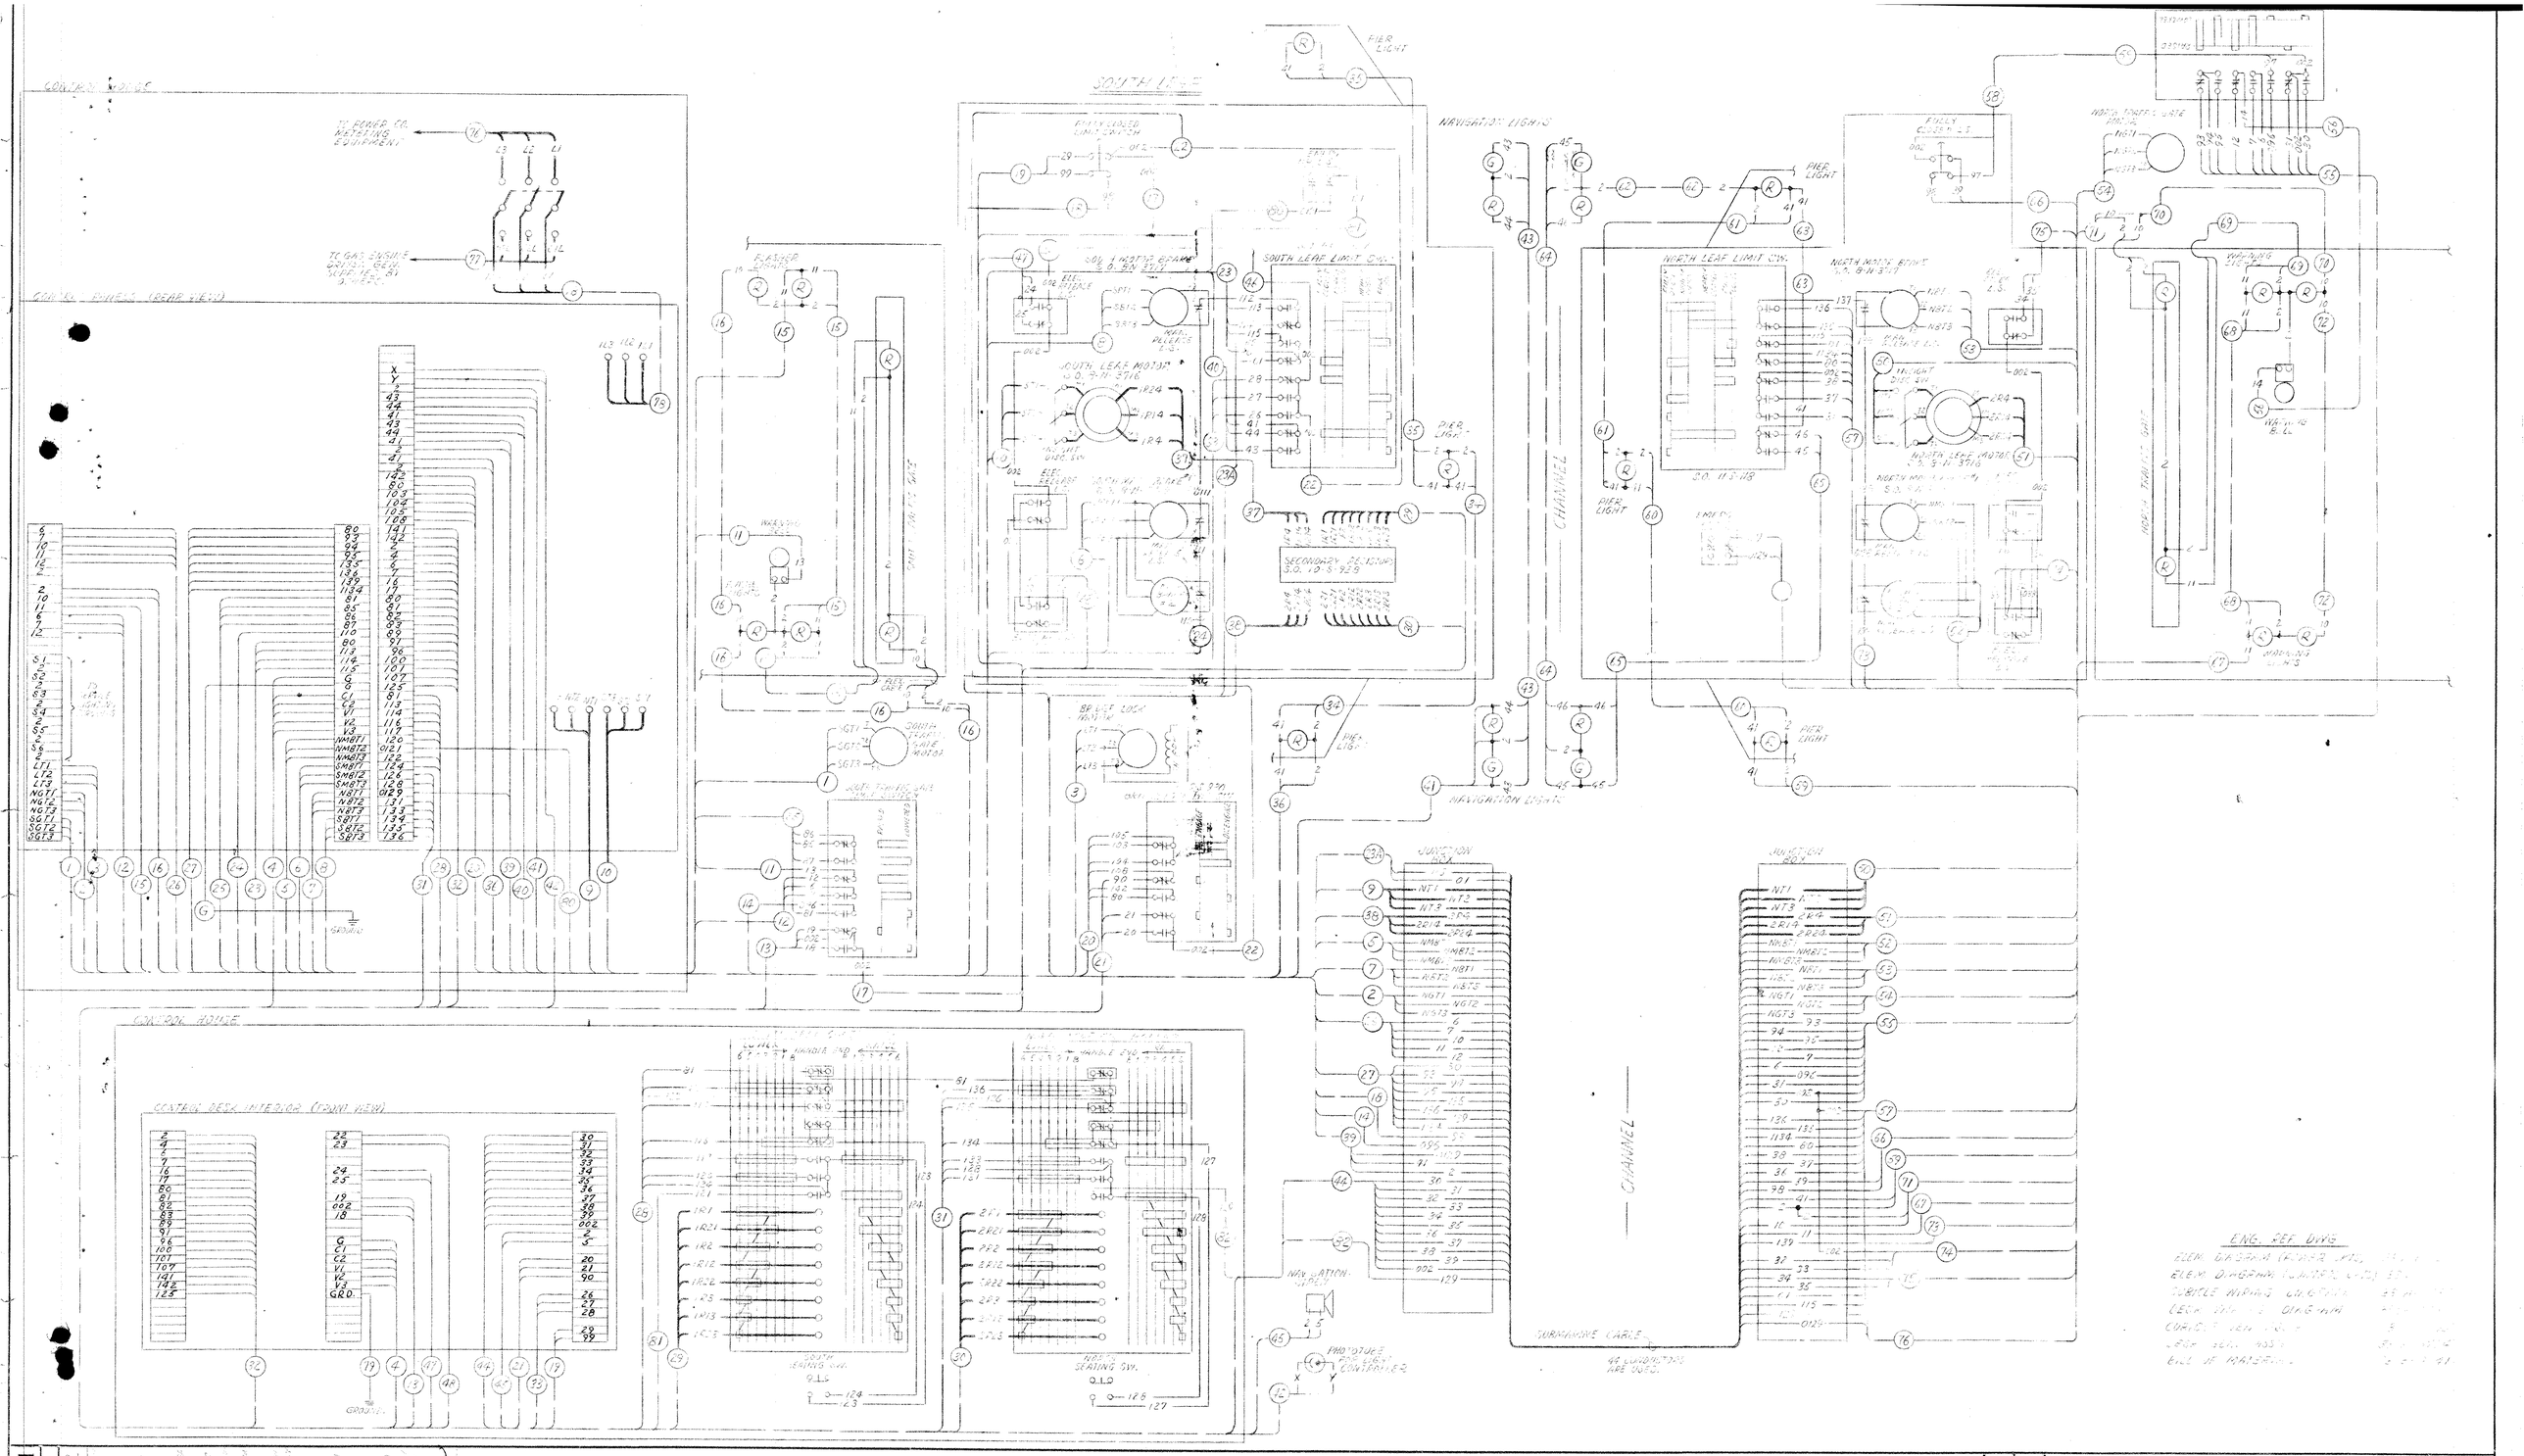

ENG. REF. DWG.

ELEV. DIAGRAM (LEAF) [illegible]
ELEV. DIAGRAM (LIMITS) [illegible]
CUBICLE WIRING DIAGRAM [illegible]
CONT. DIAGRAM [illegible]
CONDUIT PLAN [illegible]
CONT. DESK [illegible]
BILL OF MATERIAL [illegible]

S.O.	CHANGE	IT.
1		

WE Shown 6-5-51

WESTINGHOUSE ELECTRIC CORPORATION

TITLE [illegible] CONTROLS [illegible] NORTH LEAF SHOCK [illegible]

DFTM. [illegible]		APPD. [illegible]	7/10/50	33-A-6798
CHKD. [illegible]		APPD. [illegible]	7/17/50	
CIV. & PLANT LOCATION				

TOOL REF. DWG. | ENG. REF. DWG.

BUFFALO DIVISIONS, BUFFALO, N. Y., U.S.A.

ENG. DEPT. FORM NO. 18166 A

PITTSBURGH PENCIL TRACING CLOTH